

New Location
 Drill Deeper
 Abandonment

Company Aggie Oil & Gas Co.
 Address 1321 Fourth St, Portsmouth, Ohio
 Farm Orla Adams
 Tract 1 Acres 89 1/2 Lease No. _____
 Well (Farm) No. 1 Serial No. _____
 Elevation (Spirit Level) 927
 Quadrangle Holbrook NC
 County Doddridge District Southwest
 Engineer Parker E. Peters
 Engineer's Registration No. 485
 File No. _____ Drawing No. _____
Oct. 25, 1962 Scale 1" = 40 P.

STATE OF WEST VIRGINIA
 DEPARTMENT OF MINES
 OIL AND GAS DIVISION
 CHARLESTON

WELL LOCATION MAP
 FILE NO. DOD-907

+ Denotes location of well on United States Topographic Maps, scale 1 to 62,500, latitude and longitude lines being represented by border lines as shown.

— Denotes one inch spaces on border line of original tracing.



STATE OF WEST VIRGINIA
DEPARTMENT OF MINES
OIL AND GAS DIVISION **Z**

Quadrangle Holbrook

Permit No. D6D - 207

WELL RECORD

Oil or Gas Well Oil & Gas
(KIND)

Company AGGIE OIL & GAS COMPANY
Address 1321 Fourth St., Portsmouth, Ohio
Farm Orla Adams Acres 89 1/2
Location (waters) Meadow Run
Well No. 1 Elev. 927
District South West County Doddridge
The surface of tract is owned in fee by Orla Adams
Address Oxford, W. Va.
Mineral rights are owned by Orla Adams and
others Address Oxford, W. Va.
Drilling commenced Nov. 19, 1962
Drilling completed Jan. 4, 1963
Date Shot _____ From _____ To _____
With _____
Open Flow _____ /10ths Water in _____ Inch
_____ /10ths Merc. in _____ Inch
Volume Slow _____ Cu. Ft.
Rock Pressure No-Test _____ lbs. _____ hrs.
Oil Slow _____ bbls., 1st 24 hrs.
WELL ACIDIZED _____

Casing and Tubing	Used in Drilling	Left in Well	Packers
Size			Kind of Packer
16			
13	10'	10'	
10	212		Size of
8 1/4	202'		
6 3/4			Depth set
5 3/16	2018	2018	
3			Perf. top
2			Perf. bottom
Liners Used			Perf. top
			Perf. bottom

CASING CEMENTED yes SIZE 5 1/2 No. Ft. 2018' Date Dec. 23, 1962
-40 sks. cement, 6 aquagel,

LAWSON
COAL WAS ENCOUNTERED AT _____ FEET _____ INCHES
_____ FEET _____ INCHES _____ FEET _____ INCHES
_____ FEET _____ INCHES _____ FEET _____ INCHES


WELL FRACTURED Jan. 19, 1963 with 24,000 92' Water well, 22,000 lb sand.

RESULT AFTER TREATMENT 1 bbl. Oil 50 M Gas

ROCK PRESSURE AFTER TREATMENT xxxxx 235 # 9 1/2 hrs.

Fresh Water _____ Feet Salt Water _____ Feet

Formation	Color	Hard or Soft	Top	Bottom	Oil, Gas or Water	Depth	Remarks
Clay			0	10			
Red Rock			10	15			
Sand			15	60			
Slate			60	75			
Red Rock			75	115			
Sand			115	125			
Slate			125	135			
Red Rock			135	145			
Slate			145	155			
Slate & Lime			155	198			
Black Slate			198	203			
Blue Slate			203	244			
Red Rock			244	262			
Slate & Shell			262	280			
Sand			280	295			
Red Rock			295	315			
Slate Lime			315	331			
Red Rock			331	337			
Blue Lime		hard	337	380			
Blue Slate			380	395			
Red Rock			395	413			
Slate			413	450			
Slate & Sand			450	455			
Sand			455	455			
Broken Lime			465	476			
Red Rock			476	503			
Slate Shell			503	575			
Sand			575	580			
Slate			580	612			
Red Rock			612	665			

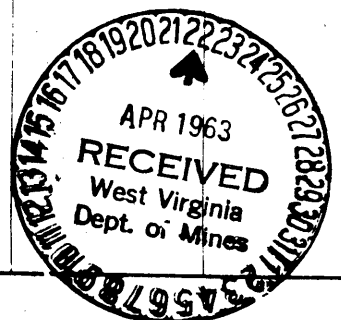

Formation	Color	Hard or Soft	Top λ	Bottom	Oil, Gas or Water	Depth Found	Remarks
Slate			665	692			
Lime		hard	692	722			
Slate & Shell			722	780			
Red Rock			780	867			
Sand			867	890			
Lime			890	935			
Slate			935	1050			
Sand			1050	1071			
Pink Rock			1071	1080			
Slate			1080	1190			
Sand			1190	1240			
Slate & Lime			1240	1334	Show Gas	1210 to	1213
Sand			1334	1495			
Lime			1495	1520			
Sand & Slate			1520	1780	Smell Gas	1740	
Sand & Lime			1780	1808			
Slate			1808	1818			
Lime			1818	1825			
Sand			1825	1842	Gas & show Oil in Matton		
Slate & Sand			1842	1870			
Gritty Lime			1870	1917			
Sand			1917	1924			
Lime			1924	1954	Little Lime		
Shale			1954	1973			
Lime			1973	2032	Big Lime		
Slate & Lime			2032	2036			
Lime & Sand			2036	2045			
Sand			2045	2085	Smell Oil & Gas	2060 - 2064	
Slate			2085	2086	Show Gas	2075	
Sand			2086	2090	" " "	2084	
Slate			2090	2091			
Sand			2091	2099	Squaw		
Slate			2099				

052

Date 6-20, 1963

APPROVED _____, Owner

By Richard S. [Signature]
(Title)