

Company RYAN CONSOLIDATED PETROLEUM CO.  
 Address 3400 Republic Nat. Bank Bldg., Dallas, 1, Tex.  
 Farm Jabez Pearcey's Hrs. Unit "B"  
 Tract \_\_\_\_\_ Acres 61 Lease No. \_\_\_\_\_  
 Well (Farm) No. One & Two Serial No. \_\_\_\_\_  
 Elevation (Spirit Level) No 1 = 1087 No 2 = 1103  
 Quadrangle Vadis NW  
 County Doddridge District New Milton  
 Engineer [Signature]  
 Engineer's Registration No. 1227  
 File No. \_\_\_\_\_ Drawing No. \_\_\_\_\_  
 Date Nov. 26, 1962 Scale 1" = 20p = 330'

STATE OF WEST VIRGINIA  
 DEPARTMENT OF MINES  
 OIL AND GAS DIVISION  
 CHARLESTON

**WELL LOCATION MAP**  
 FILE NO. Dod - 915 - #1  
Dod - 916 - #2

+ Denotes location of well on United States Topographic Maps, scale 1 to 62,500, latitude and longitude lines being represented by border lines as shown.

- Denotes one inch spaces on border line of original tracing.

66 134



STATE OF WEST VIRGINIA  
DEPARTMENT OF MINES  
OIL AND GAS DIVISION 4

Rotary   
Spudder   
Cable Tools   
Storage

Quadrangle Vadis

Permit No. DOD - 916

WELL RECORD

Oil or Gas Well OIL  
(KIND)

Company Ryan consolidated Petroleum Corporation  
Address 3400 Republic National Bank Bldg, Dallas, Tex  
Farm Elizabeth & Jabez Pearcy Heirs Acres 61  
Location (waters) Tom's Run  
Well No. Unit B #1 Elev. 1087 GL  
District New Milton County Doddridge  
The surface of tract is owned in fee by Paul Robinson et al  
West Union Address West Virginia  
Mineral rights are owned by Paul Robinson et al  
West Union Address West Virginia  
Drilling commenced March 16, 1963  
Drilling completed April 16, 1963  
Date Shot \_\_\_\_\_ From \_\_\_\_\_ To \_\_\_\_\_  
With \_\_\_\_\_  
Open Flow /10ths Water in \_\_\_\_\_ Inch  
/10ths Merc. in \_\_\_\_\_ Inch  
Volume \_\_\_\_\_ Cu. Ft.  
Rock Pressure \_\_\_\_\_ lbs. \_\_\_\_\_ hrs.  
Oil \_\_\_\_\_ bbls., 1st 24 hrs.  
WELL ACIDIZED \_\_\_\_\_

Casing and Tubing	Used in Drilling	Left in Well	Packers
Size			Kind of Packer
16			
13			
10	350'	None	Size of _____
8 1/4 8"	1031	None	Depth set _____
6 5/8			
5 3/16			
3 4 1/2"		2150	Perf. top <u>2040'</u>
2			Perf. bottom <u>2050'</u>
Liners Used			Perf. top _____
			Perf. bottom _____

CASING CEMENTED 4 1/2" SIZE 2150' No. Ft. 4-19-63 Date  
approx. 166 sks. cement. - THE WESTERN CO  
COAL WAS ENCOUNTERED AT \_\_\_\_\_ FEET \_\_\_\_\_ INCHES  
\_\_\_\_\_ FEET \_\_\_\_\_ INCHES FEET \_\_\_\_\_ INCHES  
\_\_\_\_\_ FEET \_\_\_\_\_ INCHES FEET \_\_\_\_\_ INCHES


WELL FRACTURED With 50,000# sand and 800 barrels water

RESULT AFTER TREATMENT 167 barrels oil in 14 hours

ROCK PRESSURE AFTER TREATMENT 675#

Fresh Water none logged Feet \_\_\_\_\_ Salt Water none logged Feet \_\_\_\_\_

Formation	Color	Hard or Soft	Top	Bottom	Oil, Gas or Water	Depth	Remarks
Soil			0	25			
Slate			25	35			
Sand			35	45			
Slate			45	230			
Sand			230	260			
Slate			260	338			
Red Rock			338	405			
Sand			405	425			
Red Rock			425	440			
Slate			440	459			
Sand			459	481			
Slate			481	500			
Sand			500	520			
Slate			520	558			
Sand			558	576			
Slate			576	720			
Red Rock			720	731			
Slate			731	750			
Red Rock			750	815			
Slate			815	828			
Red Rock			828	900			
Slate			900	928			
Red Rock			928	990			
Slate			990	1030			
Sand			1030	1040			
Slate			1040	1251			
Sand			1251	1301			
Slate			1301	1368			
Sand			1368	1378			

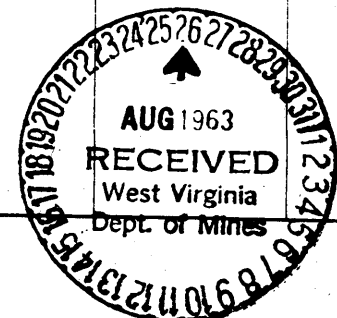

Formation	Color	Hard or Soft	Top 4	Bottom	Oil, Gas or Water	Depth Found	Remarks
Slate			1378	1440			
Sand			1440	1502			
Slate			1502	1635			
Sand			1635	1720			
Slate			1720	1865			
Sand			1865	1887			
Lime			1887	1895			
Slate			1895	1909			
Lime			1909	1920			
Slate			1920	1923			
Blue Monday Sand			1923	1947	Oil	1935-1939	
Slate			1947	1949			
Big Lime			1949	2015	Oil	1950-1957	Gas 1958
Big Injun Sand			2015	2104	Oil	2027 88 mcf	natural free o
Slate			2104	2112		2053	(Slight increase in oil)

Date 21 August, 19 63

APPROVED Ryan Consolidated Petroleum Corporation, Owner

By R. R. Toevs  
R. R. Toevs (Title) Landman