

- New Location .
- Drill Deeper . . . .
- Redrill . . . . .
- Abandonment . . . . .

I, the undersigned, hereby certify that this map is correct to the best of my knowledge and belief and shows all the information required by paragraph 6 of the rules and regulations required by the oil and gas section of the mining laws of West Virginia.

Company	CARLE SMITH INC.
Address	SANDYVILLE, W. VA.
Farm	J. H. MARTIN
Tract	Acres 142 Lease No.
Well (Farm) No.	2 Serial No.
Elevation (Spirit Level)	1062.60 RUN FROM FORKS ROAD ON MORGAN RUN ELEV. 2321
Quadrangle	CENTER POINT SC
County	DODDRIDGE District GRANT
Engineer	L. J. Dye
Engineer's Registration No.	804
File No.	Drawing No.
Date	1-21-63 Scale 1" = 40 FEET

STATE OF WEST VIRGINIA  
 DEPARTMENT OF MINES  
 OIL AND GAS DIVISION  
 CHARLESTON  
**WELL LOCATION MAP**  
 FILE NO. DOD-926

+ Denotes location of well on United States Topographic Maps, scale 1 to 62,500, latitude and longitude lines being represented by border lines as shown.  
 — Denotes one inch spaces on border line of original tracing.

2-0-2-99



STATE OF WEST VIRGINIA  
DEPARTMENT OF MINES  
OIL AND GAS DIVISION 4

Quadrangle Centerpoint  
Permit No. DOD-926

WELL RECORD

Oil or Gas Well None  
(KIND)

Company Carl E. Smith, Inc.  
Address Sandyville, W. Va.  
Farm J. H. Martin Acres 1 1/2  
Location (waters) \_\_\_\_\_  
Well No. 2 Elev. 1052.60  
District Grant County Doddridge  
The surface of tract is owned in fee by  
Martin Heirs Address West Union, W. Va.  
Mineral rights are owned by  
Martin Heirs Address West Union, W. Va.  
Drilling commenced March 28, 1963  
Drilling completed May 18, 1963  
Date Shot \_\_\_\_\_ From \_\_\_\_\_ To \_\_\_\_\_  
With \_\_\_\_\_  
Open Flow /10ths Water in \_\_\_\_\_ Inch  
/10ths Merc. in \_\_\_\_\_ Inch  
Volume \_\_\_\_\_ Cu. Ft.  
Rock Pressure \_\_\_\_\_ lbs. \_\_\_\_\_ hrs.  
Oil \_\_\_\_\_ bbls., 1st 24 hrs.  
WELL ACIDIZED \_\_\_\_\_  
WELL FRACTURED \_\_\_\_\_

Casing and Tubing	Used in Drilling	Left in Well	Packers
Size			Kind of Packer
16	9		
13			
10	306'		Size of
8 1/4	1063'		
6 3/4	1595'		Depth set
5 3/16	2,043'		
3			Perf. top
2			Perf. bottom
Liners Used			Perf. top
			Perf. bottom

CASING CEMENTED X SIZE 5" No. Ft. 90' Date  
May 11, 1963


COAL WAS ENCOUNTERED AT \_\_\_\_\_ FEET \_\_\_\_\_ INCHES  
\_\_\_\_\_ FEET \_\_\_\_\_ INCHES \_\_\_\_\_ FEET \_\_\_\_\_ INCHES  
\_\_\_\_\_ FEET \_\_\_\_\_ INCHES \_\_\_\_\_ FEET \_\_\_\_\_ INCHES

RESULT AFTER TREATMENT

ROCK PRESSURE AFTER TREATMENT

Fresh Water 80 Feet Salt Water \_\_\_\_\_ Feet

Formation	Color	Hard or Soft	Top	Bottom	Oil, Gas or Water	Depth	Remarks
Slate & Rock	Red		0	385	Water	80	
Sand & Slate		Hard	385	495			
Lime		Hard	495	530			
Lime & Slate		Hard	530	595			
Lime & Sand			595	644			
Slate			644	701			
Lime			701	760			
Slate, Rock	Red		760	818			
Lime			818	858			
Red Rock	Red		858	908			
Slate			908	952			
Lime			952	997			
Red Rock			997	1084			
Slate			1084	1100			
Slate & Shell			1100	1135			
Slate & Lime			1135	1175			
Shell			1175	1230			
Lime			1230	1284			
Slate & Shell			1284	1339			
Sand			1339	1388			
Slate & Sand			1388	1565			
Sand		Hard	1565	1592			
Lime			1592	1612			
Slate			1612	1643			
Sand			1643	1791	Gas	1725 & 1763	show
Maxton Sand			1791	1882	Gas	1840	show
Sand		Hard	1882	1911			
Big Lime			1911	2035			
Injun			2035	2160			

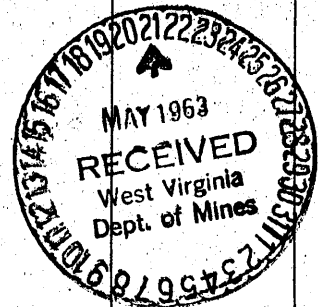

Formation	Color	Hard or Soft	Top <sup>4</sup>	Bottom	Oil, Gas or Water	Depth Found	Remarks
Slate Lime			2160 2165	2165 2168			

Date May 21, 19 63

APPROVED Carl E. Smith, Inc., Owner

By \_\_\_\_\_ (Title) President