

Company CREST OIL CO.

Address Box 57, Alton, Illinois.

Farm Henry A'House's Heirs

Tract _____ Acres 50 Lease No. _____

Well (Farm) No. One Serial No. _____

Elevation (Spirit Level) 1277'

Quadrangle Vadis WC

County Doddridge District New Milton

Engineer M. Street J.

Engineer's Registration No. 1227

File No. _____ Drawing No. _____

Date April 22, 1963 Scale 1" = 30p = 495

STATE OF WEST VIRGINIA
DEPARTMENT OF MINES
OIL AND GAS DIVISION
CHARLESTON

WELL LOCATION MAP

FILE NO. Dod - 964

+ Denotes location of well on United States Topographic Maps, scale 1 to 62,500, latitude and longitude lines being represented by border lines as shown.

- Denotes one inch spaces on border line of original tracing.

M. Street J.

6-9-397



STATE OF WEST VIRGINIA
DEPARTMENT OF MINES
OIL AND GAS DIVISION 8

Quadrangle Vadis

Permit No. 964

WELL RECORD

Oil or Gas Well Oil
(KIND)

Company Crest Oil Co.
Address Box 57, Alton, Ill.
Farm Henry Ahouse Acres So. 50
Location (waters) Brushy Fork
Well No. 1 Elev. 1277'
District New Milton County Doddridge
The surface of tract is owned in fee by C. C. Haught
et als Address West Union, W. Va
Mineral rights are owned by C. C. Haught et als
Address West Union, W. Va
Drilling commenced 5-11-63 Rotary
Drilling completed 6-1-63
Date Shot _____ From _____ To _____
With _____
Open Flow _____ /10ths Water in _____ Inch
_____ /10ths Merc. in _____ Inch
Volume _____ Cu. Ft.
Rock Pressure 1st. 900 lbs. 24 hrs.
Oil 101 bbls., 1st 24 hrs.
WELL ACIDIZED No
WELL FRACTURED No

Casing and Tubing	Used in Drilling	Left in Well	Packers
Size			Kind of Packer
16			
13			Size of
10			
8 1/4			Depth set
7"	50'	50'	
5 3/16			Perf. top
5 1/2"	2420'	2420'	Perf. bottom
2			Perf. top
Liners Used			Perf. bottom


CASING CEMENTED 5 1/2" SIZE No. Pt 5-26-63 Date
40 sks cement Lawson
COAL WAS ENCOUNTERED AT _____ FEET _____ INCHES
_____ FEET _____ INCHES FEET _____ INCHES
_____ FEET _____ INCHES FEET _____ INCHES

RESULT AFTER TREATMENT

ROCK PRESSURE AFTER TREATMENT

Fresh Water No Feet _____ Salt Water No Feet _____

Formation	Color	Hard or Soft	Top	Bottom	Oil, Gas or Water	Depth	Remarks
Shale & Shells			0	80			
Shale			80	184			
Red Bed			184	350			
Shale & Shells			350	495			
Shale			495	646			
Shale & Red Bed			646	818			
Red Bed							
Shale & Sand			818	948			
Shale & Sand			948	1009			
Shale & Sand			1009	1120			
Sand & Shells			1120	1240			
Sand & Shale			1240	1370			
Sand & Shale			1370	1388			
Sand			1388	1403			
Shale & Sand			1403	1515			
Sand			1515	1600			
Sand			1600	1644			
Shale & Sand			1644	1700			

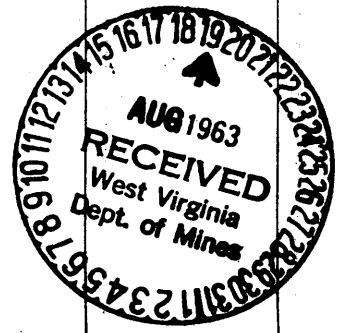

Formation	Color	Hard or Soft 8	Top	Bottom	Oil, Gas or Water	Depth Found	Remarks
Sand & Sandy Shale			1700	1755			
Sand			1755	1826			
Sand & Shale			1826	1853			
Limey Sand			1853	1884			
Sand Shale & Lime			1884	1934			
Sand & Shale			1934	2060			
Sandy Lime			2060	2180			
Sand & Shale			2180	2265			
Sand Lime & Shale			2265	2366			
Lime	Little Lime		2366	2384			
Sand & Shale			2384	2406			
Lime	Big Lime		2406	2461	Gas	2439	
Sand	Big Injun		2461	2528	Gas & Oil	2490	

Date Aug. 16, 1963

APPROVED Crest Oil Company, Owner

By C. F. Swain
C. F. Swain (Title) (Owner)