

Elevation Reference
 U. S. G. S elevation 850
 at mouth of Wesley Fork

I, the undersigned, hereby certify that this map is correct to the best of my knowledge and belief and shows all of the information required by paragraph 6 of the rules and regulations of the oil and gas section of the mining laws of West Virginia.

W. H. Bluff
 E. P. S. No. 1227

- New Location
- Drill Deeper
- Abandonment

error in closure - 6.915 less than 1" in 200'

Company Ryan Consolidated Pet. Co.
 Address 3400 Republic Nat. Bank Bldg. Dallas, L. Texas.
 Farm (SHERMAN STOUT - SUGARBEE)
Jabes Paracey Mrs.
 Tract _____ Acres 63.75 Lease No. _____
 Well (Farm) No. One Serial No. _____
 Elevation (Spirit Level) 968
 Quadrangle Vadis NW
 County Doddridge District New Milton
 Engineer W. H. Bluff
 Engineer's Registration No. 1227
 File No. _____ Drawing No. _____
 Date July 16, 1963 Scale 1" = 200' = 230'

STATE OF WEST VIRGINIA
 DEPARTMENT OF MINES
 OIL AND GAS DIVISION
 CHARLESTON

WELL LOCATION MAP
 FILE NO. Dod-1037

+ Denotes location of well on United States Topographic Maps, scale 1 to 82,500, latitude and longitude lines being represented by border lines as shown.
 - Denotes one inch spaces on a border line of original tracing.



STATE OF WEST VIRGINIA
DEPARTMENT OF MINES
OIL AND GAS DIVISION 9

Quadrangle Vadis
Permit No. DOD 1037

WELL RECORD

Oil or Gas Well Oil
(KIND)

Company <u>Ryan Consolidated Petroleum Corp.</u>	Casing and Tubing	Used in Drilling	Left in Well	Packers
Address <u>3400 Republic National Bank Bldg., Dallas</u>				
Farm <u>Jabez Pearcy</u> Acres <u>62.75</u>				
Location (waters) _____	Size			
Well No. <u>1 "C"</u> Elev. <u>968</u>	16 <u>30'</u>		<u>30'</u>	Kind of Packer _____
District <u>New Milton</u> County <u>Doddridge</u>	13 _____			
The surface of tract is owned in fee by <u>Sherman Stout</u>	10 <u>426</u>	<u>426</u>	<u>246'</u>	Size of _____
Address _____	8 <u>1065</u>	<u>1065</u>	<u>847</u>	
Mineral rights are owned by <u>Pearcy Heirs</u>	6 <u>1427</u>	<u>1427</u>		Depth set _____
Address <u>4-1/2</u>	5 <u>1999</u>		<u>1999</u>	
Drilling commenced <u>June 29, 1963</u>	3 _____			Perf. top _____
Drilling completed <u>July 25, 1963</u>	2 <u>1900</u>		<u>1900</u>	Perf. bottom _____
Date Shot _____ From _____ To _____	Liners Used _____			Perf. top _____
With <u>None</u>				Perf. bottom _____
Open Flow _____ /10ths Water in _____ Inch				
_____ /10ths Merc. in _____ Inch				
Volume _____ Cu. Ft.				
Rock Pressure _____ lbs. _____ hrs.				
Oil <u>50</u> bbls., 1st 24 hrs.				
WELL ACIDIZED <u>No</u>				

CASING CEMENTED Yes SIZE 4-1/2 No. Ft. 1999 Date
with 66 sax Halliburton

COAL WAS ENCOUNTERED AT _____ FEET _____ INCHES
_____ FEET _____ INCHES _____ FEET _____ INCHES
_____ FEET _____ INCHES _____ FEET _____ INCHES


WELL FRACTURED July 26, 1963 - 50,000 lbs. sand - 800 bbls. water

RESULT AFTER TREATMENT 50 barrels per day

ROCK PRESSURE AFTER TREATMENT _____

Fresh Water None Feet _____ Salt Water None Feet _____

Formation	Color	Hard or Soft	Top	Bottom	Oil, Gas or Water	Depth	Remarks
Soil			0	10			
Rock	Red		10	25			
Sand			25	68			
Shale	Grey		68	104			
Sand			104	137			
Slate			137	156			
Sand			156	180			
Slate			180	198			
Rock	Red		198	268			
Sand			268	336			
Slate			336	350			
Rock	Red		350	381			
Sand			381	412			
Slate			412	441			
Lime			441	453			
Slate & Shells			453	560			
Shale			560	585			
Rock	Red		585	652			
Slate			652	664			
Rock	Red		664	693			
Slate			693	706			
Rock	Red		706	740			
Slate			740	794			
Lime			794	824			
Rock	Red		824	860			

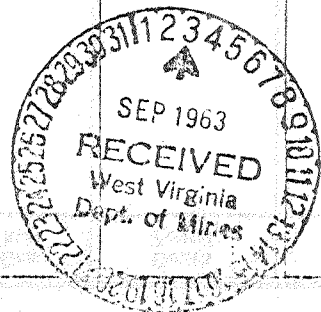

Formation	Color	Hard or Soft	Top ⁹	Bottom	Oil, Gas or Water	Depth Found	Remarks
Slate	Grey		860	925			
Slate	Black		925	962			
Slate	Grey		962	975			
Sand			975	995			
Shale	Grey		995	1053			
Lime			1053	1067			
Sand			1067	1105			
Shale	Black		1105	1232			
Sand			1232	1242			
Lime			1242	1253			
Slate and Shells			1253	1265			
Sand			1265	1354			
Shale	Black		1354	1427			
Slate	Grey		1427	1450			
Lime			1450	1488			
Slate	Black		1488	1502			
Lime			1502	1510			
Sand			1510	1568			
Sand (Broken)			1568	1592			
Slate	Black		1592	1714			
Little Lime			1714	1770			
Sand			1770	1798			
Big Lime Fm.			1798	1890			
Big Injun Sand			1890	1935			
Slate & Shells			1935	1997			
			T.D.	1997 Drillers			
			T.D.	1999 Loggers			

Date 8-29, 1963

APPROVED Walter Geogler, Owner

By V.P. (Title)