

1.3225  
0.65

PROP. COR.  
2.5136 2000  
1.265 3920  
0.59W 8050 9/16/98

MINIMUM ERROR OF CLOSURE 1 / 2500  
SOURCE OF ELEVATION B.M. WEST UNION 836

RE-ENTRY   
Drill Deeper   
Abandonment

"I, THE UNDERSIGNED, HEREBY CERTIFY THAT THIS MAP IS CORRECT TO THE BEST OF MY KNOWLEDGE AND BELIEF AND SHOWS ALL THE INFORMATION REQUIRED BY PARAGRAPH 6 OF THE RULES AND REGULATIONS OF THE OIL AND GAS SECTION OF THE MINING LAWS OF WEST VIRGINIA."

Company PROIR OIL COMPANY  
 Address UNION TRUST BLDG. PARKERSBURG, W. VA.  
 Farm AUDRY DOTSON  
 Tract 1 Acres 41.12 Lease No. \_\_\_\_\_  
 Well (Farm) No. 1 Serial No. \_\_\_\_\_  
 Elevation (Spirit Level) 967'  
 Quadrangle WEST UNION - SC  
 County DODDRIDGE District CENTRAL  
 Engineer Gordon C. Ralls  
 Engineer's Registration No. 4052  
 File No. \_\_\_\_\_ Drawing No. \_\_\_\_\_  
 Date JANUARY 27, 1964 Scale 1" = 200'

STATE OF WEST VIRGINIA  
 DEPARTMENT OF MINES  
 OIL AND GAS DIVISION  
 CHARLESTON

WELL LOCATION MAP  
 FILE NO. Dod-1094-R  
 (WAS 017 30484) 11456

+ Denotes location of well on United States Topographic Maps, scale 1 to 62,500, latitude and longitude lines being represented by border lines as shown.

— Denotes one inch spaces on border line of original tracing.

135  
~~135~~  
S. 67 W

Longitude 80 50

William Ramsey



Dwg

David Smith

Audra Dotson  
41A

Finley Dotson

No. 1  
Elev. 987

No. 2

North

McHenry Dotson

New Location   
Drill Deeper   
Abandonment

Company Reno Oil Co  
Address Sistersville, W. Va.  
Farm Audra Dotson  
Tract \_\_\_\_\_ Acres 41 Lease No. \_\_\_\_\_  
Well (Farm) No. 1 Serial No. \_\_\_\_\_  
Elevation (Spirit Level) 987  
Quadrangle West Union  
County Doddridge District Central  
Engineer A. N. Wierfull  
Engineer's Registration No. Surveyor, Ritchie Co.  
File No. \_\_\_\_\_ Drawing No. \_\_\_\_\_  
Date April 3, 1945 Scale 1" = 20 Poles

STATE OF WEST VIRGINIA  
DEPARTMENT OF MINES  
OIL AND GAS DIVISION  
CHARLESTON

WELL LOCATION MAP

FILE NO. DOD-484-A  
NOW: 017 1094

+ Denotes location of well on United States Topographic Maps, scale 1 to 62,500. Latitude and longitude lines being represented by border lines as shown.

- Denotes one inch spaces on border line of original tracing.



COPY

992

STATE OF WEST VIRGINIA  
DEPARTMENT OF MINES  
OIL AND GAS DIVISION

WELL RECORD

Permit No. DOD-484-A

Oil or Gas Well Oil  
(KIND)


Company Reno Oil Company  
Address Sistersville, West Virginia  
Farm Audra Dotson Acres 41  
Location (waters) \_\_\_\_\_  
Well No. 1 Elev. 987  
District Central County Doddridge  
The surface of tract is owned in fee by Willie Andrew  
Address West Union  
Mineral rights are owned by Willie Andrew  
Address West Union  
Drilling commenced June 14, 1920  
Drilling completed August 11, 1920  
Date Shot 8-19-20 From 1920 To 2047  
With \_\_\_\_\_  
Open Flow \_\_\_\_\_ /10ths Water in \_\_\_\_\_ Inch  
\_\_\_\_\_ /10ths Merc. in \_\_\_\_\_ Inch  
Volume \_\_\_\_\_ Cu. Ft.  
Rock Pressure \_\_\_\_\_ lbs. \_\_\_\_\_ hrs.  
Oil \_\_\_\_\_ bbls., 1st 24 hrs.  
Fresh water \_\_\_\_\_ feet \_\_\_\_\_ feet  
Salt water \_\_\_\_\_ feet \_\_\_\_\_ feet

Casing and Tubing	Used in Drilling	Left in Well	Packers
Size			
16			Kind of Packer _____
13			
10	560	None	Size of _____
8 1/4	1128	"	
6 5/8	1899	1899	Depth set _____
5 3/16			
3			Perf. top _____
2			Perf. bottom _____
Liners Used			Perf. top _____
			Perf. bottom _____

CASING CEMENTED \_\_\_\_\_ SIZE \_\_\_\_\_ No. Ft. \_\_\_\_\_ Date \_\_\_\_\_

COAL WAS ENCOUNTERED AT \_\_\_\_\_ FEET \_\_\_\_\_ INCHES  
\_\_\_\_\_ FEET \_\_\_\_\_ INCHES \_\_\_\_\_ FEET \_\_\_\_\_ INCHES  
\_\_\_\_\_ FEET \_\_\_\_\_ INCHES \_\_\_\_\_ FEET \_\_\_\_\_ INCHES

Formation	Color	Hard or Soft	Top	Bottom	Oil, Gas or Water	Depth Found	Remarks
Hurry Up Sand			496	560			
Little Dunkard			1095	1138			
Big Dunkard			1151	1166			
Gas Sand			1387	1410			
1st Salt Sand			1453	1535			
2d Salt Sand			1612	1658			
3d Salt Sand			1675	1725			
Maxton Sand			1820	1838			
Little Lime			1845	1860			
Pencil Cave			1860	1871			
Blue Monday			1871	1876			
Break			1876	1879			
Gas					1960 Gas		
Big Lime			1879	1956	2048 Gas		
Injun Sand			1956	2055	2051 Oil		
Total Depth				2070			

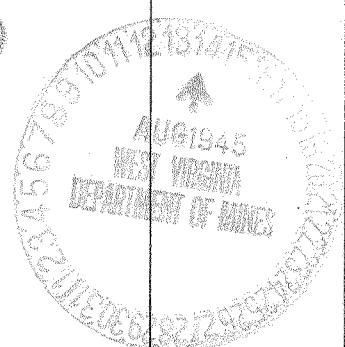





STATE OF WEST VIRGINIA  
DEPARTMENT OF MINES  
OIL AND GAS DIVISION

Rotary   
Spudder   
Cable Tools   
Storage

Quadrangle WEST UNION  
Permit No. DOD - 1094 REDRILL

WELL RECORD

Oil or Gas Well D/H

Company PRIOR OIL COMPANY  
Address 720 UNION TRUST BLDG., PARKERSBURG, W. VA.  
Farm AUDREY DOTSTON Acres 41  
Location (waters) LONG RUN  
Well No. 1 Elev. 967  
District CENTRAL County DODDRIDGE  
The surface of tract is owned in fee by J. C. SHEPHERD  
Address GREENWOOD, W. VA.  
Mineral rights are owned by GUY LONG  
Address SISTERSVILLE, W. VA.  
Drilling commenced 2/21/64  
Drilling completed 2/23/64  
Date Shot From To  
Flow 10ths Water in Inch  
10ths Merc. in Inch  
Volume Cu. Ft.  
Rock Pressure lbs. hrs.  
Oil bbls., 1st 24 hrs.  
WELL ACIDIZED -----  
WELL FRACTURED -----

Casing and Tubing	Used in Drilling	Left in Well	Packers
Size			Kind of Packer
16			
13			Size of
10			
8 1/4	20	20	Depth set
6 5/8			
5 3/16			Perf. top
3			Perf. bottom
2			Perf. top
Liners Used			Perf. bottom

CASING CEMENTED --- SIZE --- No. Ft. --- Date

COAL WAS ENCOUNTERED AT FEET INCHES  
NO COAL  
FEET INCHES FEET INCHES  
FEET INCHES FEET INCHES

RESULT AFTER TREATMENT ----- ROTARY-DRILLED WITH CIRCULATING GEL & MUD  
ROCK PRESSURE AFTER TREATMENT -----  
Fresh Water NONE RECORDED Feet Salt Water NONE RECORDED Feet

Formation	Color	Hard or Soft	Top	Bottom	Oil, Gas or Water	Depth	Remarks
NONE (CLAY & MUD)			0	600	(NO WATER RECORDED ON ORIGINAL LOG)		

