

- New Location
- Drill Deeper
- Abandonment

Error in closure: - Less than 1' in 200'

Company A.T. CARR DRILLING CO.
 Address 218 1/2 Main Ave., Weston, W. Va.
 Farm J.C. Hought
 Tract _____ Acres 140 Lease No. _____
 Well (Farm) No. Three Serial No. _____
 Elevation (Spirit Level) 1009
 Quadrangle Yadis - WC
 County Doddridge District New Milton
 Engineer W. St. J.
 Engineer's Registration No. 1227
 File No. _____ Drawing No. _____
 Date Feb. 8, 1964 Scale 1" = 40p = 660'

STATE OF WEST VIRGINIA
 DEPARTMENT OF MINES
 OIL AND GAS DIVISION
 CHARLESTON

WELL LOCATION MAP
 FILE NO. Dod-1121

+ Denotes location of well on United States Topographic Maps, scale 1 to 62,500, latitude and longitude lines being represented by border lines as shown.
 - Denotes one inch spaces on border line of original tracing.



STATE OF WEST VIRGINIA
DEPARTMENT OF MINES
OIL AND GAS DIVISION 5

Quadrangle Vadis

WELL RECORD

Permit No. DOD 1121

Oil or Gas Well Oil
Handwritten signature
(KIND)

Company A. T. Carr Drilling
Address Box 7, Lost Creek, W. Va.
Farm J. C. Haught Acres 140
Location (waters) Brushy Fork
Well No. 3 Elev. 1009
District New Milton County Doddridge
The surface of tract is owned in fee by J. C. Haught
heirs Address Salem, W. Va.
Mineral rights are owned by Same
Address _____

Drilling commenced April 26, 1964
Drilling completed July 25, 1964
Date Shot _____ From _____ To _____
With _____

Open Flow /10ths Water in _____ Inch
/10ths Merc. in _____ Inch

Volume _____ Cu. Ft.
Rock Pressure None lbs. _____ hrs.

Oil None bbls., 1st 24 hrs.
WELL ACIDIZED 2000 gal

WELL FRACTURED No

RESULT AFTER TREATMENT None
ROCK PRESSURE AFTER TREATMENT None


Fresh Water None Feet _____ Salt Water None Feet _____

Casing and Tubing	Used in Drilling	Left in Well	Packers
Size			Kind of Packer _____
16			
13			Size of _____
10			
8 1/2	90	90	Depth set _____
6 3/4			
5 3/16			Perf. top _____
3 1/2	2232		Perf. bottom _____
2			Perf. top _____
Liners Used			Perf. bottom _____

CASING CEMENTED 4 1/2 SIZE 2232 No. Ft. _____ Date _____
Hole drilled with Rotary

COAL WAS ENCOUNTERED AT None FEET _____ INCHES
_____ FEET _____ INCHES FEET _____ INCHES
_____ FEET _____ INCHES FEET _____ INCHES

Formation	Color	Hard or Soft	Top	Bottom	Oil, Gas or Water	Depth	Remarks
Clay			0	30			
Sand			30	52			
Red Rock			52	115			
Slate			115	135			
Red Rock			135	145			
Slate			145	180			
Red Rock			180	224			
Slate			224	270			
Red Rock			270	295			
Slate			295	380			
Red Rock			380	435			
Sand			435	462			
Red Rock			462	490			
Slate			490	558			
Sand			558	571			
Shale			571	715			
Sand			715	750			
Slate			750	777			
Sand			777	790			
Slate			790	868			
Sand			868	890			
Slate			890	1030			
Sand			1030	1050			
Slate			1050	1390			
Sand			1390	1495			
Slate			1495	1690			
Sand			1690	1746			
Slate			1746	1800			
Sand			1800	1845			

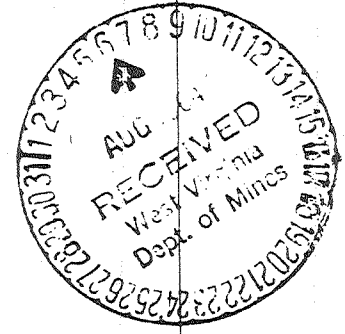

Formation	Color	Hard or Soft	Top 5	Bottom	Oil, Gas or Water	Depth Found	Remarks
Lime			1845	1855			
Sand			1855	1894			
Lime			1894	1905			
Sand			1905	1918			
Slate			1918	1990			
Lime			1990	2150			
Slate			2150	2165			
Big Lime			2165	2195			
Injun Sand			2195	2270			
Sandy Shale			2270	2560			
Gants Sand			2560	2575			
Shale			2575	2590			
Total Depth			2590				

Date August 5, 1964

APPROVED A. T. Carr, Owner

By A. T. Carr
(Title)