

production history  
 1992 - 8 mcf  
 1993 - 782 mcf

5.65  
 1.4

- Redrill.....
- New Location.
- Drill Deeper.....
- Abandonment.....

SOURCE OF ELEV. - WELL NO A-226 ELEV. 858'  
 I, the undersigned, hereby certify that this map is correct to the best of my knowledge and belief and shows all the information required by paragraph 6 of the rules and regulations of the oil and gas section of the mining laws of West Virginia.

Minimum accuracy, one part in 200

Company	ALLEGHENY LAND & MINERAL CO.		
Address	CLARKSBURG, W.V.A.		
Farm	L.A. SWIGER		
Tract	Acres	64	Lease No.
Well (Farm) No.	Serial No.	A-253	
Elevation (Spirit Level)	988'		
Quadrangle	CENTERPOINT - NE31 Folsom 7.5		
County	DODDRIDGE District M'CLELLAN		
Engineer	James J. Jeffries		
Engineer's Registration No.	1084		
File No.	208/60	Drawing No.	
Date	6-6-64	Scale	1" = 500'

STATE OF WEST VIRGINIA  
 DEPARTMENT OF MINES  
 OIL AND GAS DIVISION  
 CHARLESTON

**WELL LOCATION MAP**  
 FILE NO. DOD-1149

+ Denotes location of well on United States Topographic Maps, scale 1 to 62,500, latitude and longitude lines being represented by border lines as shown.

— Denotes one inch spaces on border line of original tracing.



STATE OF WEST VIRGINIA  
DEPARTMENT OF MINES  
OIL AND GAS DIVISION 5

Rotary   
Spudder   
Cable Tools   
Storage

Quadrangle \_\_\_\_\_

Permit No. Dod-1149

WELL RECORD

Oil or Gas Well Gas  
(KIND)

Company Allegheny Land & Mineral Company  
Address Clarksburg, W.Va.  
Farm L.A. Swiger Acres 64  
Location (waters) \_\_\_\_\_  
Well No. A-253 Elev. 988  
District McClellan County Doddridge  
The surface of tract is owned in fee by M. Swiger Heirs  
Address Salem, W.Va.  
Mineral rights are owned by Same  
Address \_\_\_\_\_

Casing and Tubing	Used in Drilling	Left in Well	Packers
Size			Kind of Packer
16	16'	16'	
13			Size of
10	310'		
8 1/2	1127'		Depth set
6 3/4			
5 3/4 4 1/2"	2173'	2173'	Perf. top <u>See back</u>
3			Perf. bottom <u>of sheet</u>
2			Perf. top _____
Liners Used			Perf. bottom _____

Drilling commenced July 10, 1964  
Drilling completed August 6, 1964  
Date Shot \_\_\_\_\_ From \_\_\_\_\_ To \_\_\_\_\_  
With \_\_\_\_\_  
Open Flow 6 /10ths Water in \_\_\_\_\_ Inch  
\_\_\_\_\_ /10ths Merc. in \_\_\_\_\_ Inch  
Volume 25,800 Cu. Ft.  
Rock Pressure Not taken lbs. \_\_\_\_\_ hrs.  
Oil Show only bbls., 1st 24 hrs.  
WELL ACIDIZED \_\_\_\_\_

CASING CEMENTED 4 1/2" SIZE 398 No. Ft. 8-7-64 Date  
100 bags cement 8 bags aquajel  
2 bags lime  
COAL WAS ENCOUNTERED AT \_\_\_\_\_ FEET \_\_\_\_\_ INCHES  
\_\_\_\_\_ FEET \_\_\_\_\_ INCHES  
\_\_\_\_\_ FEET \_\_\_\_\_ INCHES


WELL FRACTURED August 18, 1964 By Dowell- Water, sand, acid.

RESULT AFTER TREATMENT 40/10 Water 2" 267 M

ROCK PRESSURE AFTER TREATMENT 265# 12 hr.

Fresh Water 6 bailers per hr 125 Salt Water None Feet

Formation	Color	Hard or Soft	Top	Bottom	Oil, Gas or Water	Depth	Remarks
Soil			0	5			
Red mud			5	15			
Yellow clay			15	45			
Broken sand			45	55			
Red Rock			55	90			
Slate			90	120			
Sand			120	135	Fresh water	125	6 bailers per hour
Black slate			135	150			
Slate & shells			150	245			
Red Rock			245	260			
Slate			260	390			
Sand			390	415			
Lime			415	445			
Red Rock			445	460			
Slate			460	490			
Lime			490	512			
Slate & shells			512	745			
Red Rock			745	750			
Sand			750	790			
Lime			790	815			
Red Rock			815	820			
Slate			820	870			
Red Rock			870	915			
Slate			915	970			
Red Rock			970	1008			
Slate & shells			1008	1025			
Slate			1025	1052			
P ink Rock			1052	1055			
Slate			1055	1080			
Black slate			1080	1110			

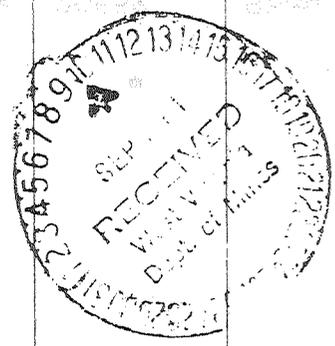

Formation	Color	Hard or Soft	Top 5	Bottom	Oil, Gas or Water	Depth Found	Remarks
Slate & shells			1110	1175			
Red Rock			1175	1190			
Slate & shells			1190	1215			
Sand			1215	1240		1948	
Slate & shells			1240	1300		989	
Sand			1300	1350		960	
Slate			1350	1475			
Sand			1475	1505			
Slate & shells			1505	1555			
Sand			1555	1575			
Slate			1575	1715			
Lime			1715	1725			
Sand			1725	1768			
Red Rock			1768	1910			
Slate			1910	1948			
Lime			1948	2014			
Keener			2014	2040	<del>Gas</del> Gas	20550	Show
Injun			2040	2165	Oil	2112-2124	1 gal per hour
Slate			2165	2173	<del>Gas</del> Gas	2055-2065	
Total depth			2173	2173	Gas	2112-2124	6/10 W 1" 25.8 M
			4 1/2" casing perforated:				
			2036	to 2039	-- 12 shots	-- Keener	
			2125 1/2	to 2128	-- 10 "	} L.M. Inj.	
			2122	to 2128	-- 20 "		
			202				
			2060	to 2064 1/2	-- 18 "	U. Inj.	

Date September 8, 1964

APPROVED Allegheny Land & Mineral Co., Owner

By Claron Dawson, Mahome, W.Va.  
(Title)

STATE OF WEST VIRGINIA  
DEPARTMENT OF ENVIRONMENTAL PROTECTION  
OFFICE OF OIL AND GAS

AFFIDAVIT OF PLUGGING AND FILLING WELL

AFFIDAVIT SHOULD BE IN TRIPLICATED, one copy mailed to the Department, one copy to be retained by the Well Operator and the third copy (and extra copies if required) should be mailed to each coal operator at their respective addresses.

Farm name: Meredith, Marta & Bryant Operator Well No: Swiger #1 10625

LOCATION: Elevation: 1010' Quadrangle: Folsom 7.5'  
District: McClellan County: Doddridge  
Latitude: 2 Feet South of 39 Deg. 27 Min. 30 Sec.  
Longitude: 10,190' Feet West of 80 Deg. 53 Min. 00 Sec.

Well Type: OIL \_\_\_\_\_ GAS X

Company: Dominion Exploration & Production, Inc. Coal Operator Marta & Bryant J. Meredith  
P O Box 1248 or Owner 1732 N. Propect Ave. #912  
Jane Lew, WV 26378 Milwaukee, WI 53202

Agent: Rodney J. Biggs Coal Operator \_\_\_\_\_  
or Owner \_\_\_\_\_

Permit Issued Date: 6/05/2001

AFFIDAVIT

STATE OF WEST VIRGINIA,  
County of Doddridge ss:

David L. Johnson being first duly sworn according to law depose and say that they are experienced in the work of plugging and filling oil and gas wells and were employed by the above named well operator, and participated in the work of plugging and filling the above well, and Mike Underwood Oil and Gas Inspector representing the Director, say that said work was commenced on the 6 day of November, 2001, and that the well was plugged and filled in the following manner:

TYPE	FROM	TO	PIPE REMOVED	LEFT
CEMENT	2018	1570		
GEL	1570	676	4 1/2" 706"	4 1/2" 1467'
CEMENT	676	576		
GEL	576	363		
CEMENT	363	256		
GEL	256	115		
CEMENT	115	SURFACE		16" 16'

Description of monument: 6" Tbg. W/ 1/4" x 12" x12" plate w/ Well No., Co. Name, API No., Date and that the work of plugging and filling said well was completed on the 8 day of NOVEMBER, 2001.

And further deponents saith not.

David L. Johnson

Sworn and subscribe before me this 9<sup>th</sup> day of November, 2001

My commission expires: December 26, 2010  
Kimberly Riffle  
Notary Public

Oil and Gas Inspector: Van Bennett 11-19-03  
for Mike Underwood

Office of the Chief  
NOV 25 2003  
WV Department  
Environmental Protection

0000 1149P

