

- New Location ..
- Drill Deeper .....
- Abandonment.....

Error in Closure: Less than 1' in 200'

Company P. & M. Oil Company  
 Address West Union, West Va.  
 Farm Greta Randolph, et al  
 Tract \_\_\_\_\_ Acres 88 Lease No. \_\_\_\_\_  
 Well (Farm) No. One Serial No. \_\_\_\_\_  
 Elevation (Spirit Level) 1192  
 Quadrangle Vadis - NW  
 County Doddridge District New Milton  
 Engineer [Signature]  
 Engineer's Registration No. 1227  
 File No. \_\_\_\_\_ Drawing No. \_\_\_\_\_  
 Date July 1, 1964 Scale 1" = 30P = 495'

STATE OF WEST VIRGINIA  
 DEPARTMENT OF MINES  
 OIL AND GAS DIVISION  
 CHARLESTON

**WELL LOCATION MAP**  
 FILE NO. Ded - 1161

+ Denotes location of well on United States Topographic Maps, scale 1 to 62,500, latitude and longitude lines being represented by border lines as shown.

- Denotes one inch spaces on border line of original tracing.

5-6 144

STATE OF WEST VIRGINIA  
DEPARTMENT OF MINES  
OIL AND GAS DIVISION

WELL RECORD

Permit No. DOD-1161


Oil or Gas Well Oil  
(Kind)

Company P. & M. Oil Company  
Address West Union, W. Va.  
Farm Greta Randolph Acres 88  
Location (waters) Meat House Fork  
Well No. 1 Elev. 1192  
District New Milton County Doddridge  
The surface of tract is owned in fee by James Davis  
New Milton, W. Va. Address  
Mineral rights are owned by Greta Randolph & Others  
Address  
Drilling commenced August 18, 1964  
Drilling completed Sept. 22, 1964  
Date shot \_\_\_\_\_ Depth of shot \_\_\_\_\_  
Open Flow /10ths Water in \_\_\_\_\_ Inch  
/10ths Merc. in \_\_\_\_\_ Inch  
Volume \_\_\_\_\_ Cu. Ft.  
Rock Pressure \_\_\_\_\_ lbs. \_\_\_\_\_ hrs.  
Oil 10 \_\_\_\_\_ bbls., 1st 24 hrs.  
Fresh water \_\_\_\_\_ feet \_\_\_\_\_ feet  
Salt water \_\_\_\_\_ feet \_\_\_\_\_ feet

Casing and Tubing	Used in Drilling	Left in Well	Packers
Size			
14			Kind of Packer
12			
10			Size of
8 1/2	610	0	
6 1/2	1305	1305	Depth set
<del>5 1/2</del> 5"		2256	
8			Perf. top
2			Perf. bottom
Liners Used			Perf. top
			Perf. bottom

CASING CEMENTED 5" SIZE 200 No. Ft. 9-18-64 Date  
COAL WAS ENCOUNTERED AT 756 FEET \_\_\_\_\_ INCHES  
\_\_\_\_\_ FEET \_\_\_\_\_ INCHES FEET \_\_\_\_\_ INCHES  
\_\_\_\_\_ FEET \_\_\_\_\_ INCHES FEET \_\_\_\_\_ INCHES

Formation	Color	Hard or Soft	Top	Bottom	Oil, Gas or Water	Depth Found	Remarks
Top soil			0	5			
Sand			5	40			
Redrock			40	70			
Slate			70	118			
Red rock			118	150			
Sand			150	175			
Slate			175	200			
Red Rock			200	250			
Slate			250	298			
Redrock			298	310			
Slate			310	363			
sand			363	390			
Redrock			390	404			
Slate			404	410			
Redrock			410	449			
Slate			449	481			
Redrock			481	490			
Slate			490	495			
Redrock			495	500			
Slate			500	545			
Redrock			545	574			
Slate			574	582			
Sand			582	606			
Slate			606	756			
Coal			756	765			
Slate			765	800			
Sand			800	830			
Slate			830	840			
Sand			840	886			
Slate			886	895			
Sand			895	915			
Red rock			915	965			
Slate			965	1000			
Redrock			1000	1000			

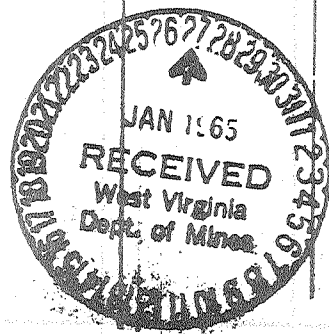

Formation	Color	Hard or Soft	Top <i>g</i>	Bottom	Oil, Gas or Water	Depth Found	Remarks
Slate			1040	1080			
Redrock			1080	1130			
Slate			1130	1190			
Sand			1190	1210			
Lime			1210	1243			
Slate			1243	1263			
Pink rock			1263	1275			
Slate			1275	1290			
Sand			1290	1320			
Slate & shells			1320	1430			
Sand			1430	1450			
Slate			1450	1504			
Sand			1504	1520			
Slate			1520	1540			
Sand			1540	1618			
Slate & shells			1618	1660			
Sand			1660	1710			
Slate			1710	1725			
Sand			1725	1775			
Slate			1775	1830			
Lime			1830	1846			
Slate & shells			1846	2042			
Maxon sand			2042	2057			
Little lime			2057	2070			
Pencil cave			2070	2080			
Blue Monday sand			2080	2122	oil	2100	Smell
Big Lime			2122	2172			
Big Injun sand			2172	2232	Gas	2173	Smell
Black Lime			2232	2244	Oil-gas	2191	2197
Sand			2244	2255	oil	2210	2214
Slate			2255	2260	Oil	2226	2232
Total Depth				2260	Oil	2244	2247

Date Oct. 1, 1964  
APPROVED H. M. Oil Co., Owner  
L. B. Pigott, Partner  
(Title)