

MINIMUM ERROR OF CLOSURE 1/300

SOURCE OF ELEVATION Junction of roads at south west corner of this 1/2 Ac. tract. Elev. 918

New Location
 Drill Deeper
 Abandonment

"I, THE UNDERSIGNED, HEREBY CERTIFY THAT THIS MAP IS CORRECT TO THE BEST OF MY KNOWLEDGE AND BELIEF AND SHOWS ALL THE INFORMATION REQUIRED BY PARAGRAPH 6 OF THE RULES AND REGULATIONS OF THE OIL AND GAS SECTION OF THE MINING LAWS OF WEST VIRGINIA."

Company J. E. Webber
 Address Morgansville, W Va.
 Farm Lawrence Monroe
 Tract 1 Acres 1/2 Lease No. _____
 Well (Farm) No. 1 Serial No. _____
 Elevation (Spirit Level) 920-OK-1126790
 Quadrangle Centerpoint - SC
 County Doddridge District Greenbrier
 Engineer Parker E Peters
 Engineer's Registration No. 485
 File No. _____ Drawing No. _____
 Date Nov. 18, 1964 Scale 1" = 500'

STATE OF WEST VIRGINIA
 DEPARTMENT OF MINES
 OIL AND GAS DIVISION
 CHARLESTON

WELL LOCATION MAP
 FILE NO. DOD-1202

+ Denotes location of well on United States Topographic Maps, scale 1 to 62,500, latitude and longitude lines being represented by border lines as shown.

— Denotes one inch spaces on border line of original tracing.



STATE OF WEST VIRGINIA
DEPARTMENT OF MINES
OIL AND GAS DIVISION 4

Quadrangle Center Point

Permit No. DOD-1202

WELL RECORD

Oil or Gas Well Oil & Gas
(KIND)

Company Webber Associates
Address Morgansville, W. Va. Rt. #1
Farm Lawrence Monroe Acres 1 1/2
Location (waters) Buffalo Branch, Greenbrier Cr Size
Well No. 1 Elev. 870' 920' 75' 70'
District Greenbrier County Doddridge
The surface of tract is owned in fee by Jack E. Webber
Address Morgansville, W. Va.
Mineral rights are owned by Jack E. Webber
Address Morgansville, W. Va.


Casing and Tubing	Used in Drilling	Left in Well	Packers
			Kind of Packer
			Size of
			Depth set
			Perf. top
			Perf. bottom
			Perf. top
			Perf. bottom

Drilling commenced 2/26/65
Drilling completed 4/3/65
Date Shot From To
With
Open Flow /10ths Water in 100,000 CFD Gas Inch
/10ths Merc. in 5 bbl. oil Inch
Volume Cu. Ft.
Rock Pressure lbs. hrs.
Oil bbls., 1st 24 hrs.
WELL ACIDIZED
WELL FRACTURED 100,000 bbl.

CASING CEMENTED 4 1/2 INCHES No. Ft. 4/6/65 Date
COAL WAS ENCOUNTERED AT 690 FEET 695 FT. INCHES
FEET INCHES FEET INCHES
FEET INCHES FEET INCHES

RESULT AFTER TREATMENT 300,000 CFD 20 Bbl. Oil
ROCK PRESSURE AFTER TREATMENT 450 #
Fresh Water Feet Salt Water Feet

Formation	Color	Hard or Soft	Top	Bottom	Oil, Gas or Water	Depth	Remarks
Soil			0	5			
Sand & Gravel			5	14			
Sand			14	25			
Red Rock			25	60			
Slate			60	98			
Sand			98	150			
Slate			150	165			
Red Rock			165	180			
Sand			180	195			
Slate			195	225			
Red Rock			225	300			
Sand			300	314			
Slate			314	324			
Red Rock			324	345			
Slate & Shell			345	365			
Sand			365	390			
Slate			390	415			
Lime			415	425			
Red Rock			425	470			
White Slate			470	485			
Slate & Shells			485	538			
Sand			538	550			
Slate			550	570			
Sand			570	580			
White Slate			580	600			
Red Rock			600	615			
Slate			615	660			
Sand			660	680			
Slate			680	690			
Coal			690	695			

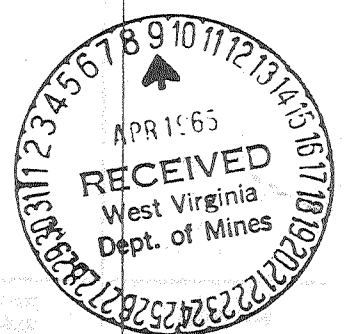

Formation	Color	Hard or Soft	Top 4	Bottom	Oil, Gas or Water	Depth Found	Remarks
Slate			695	720			
Sand			720	775			
Red Rock			775	855			
Slate			855	880			
Red Rock			880	935			
Lime			935	975			
Slate			975	1018			
Red Rock			1018	1046			
Sand			1046	1063			
Slate			1063	1100			
Red Rock			1100	1121			
Slate & Shell			1121	1125			
Sandy Lime			1125	1160			
Slate & Shell			1160	1220			
Sand			1220	1245			
Slate & Shell			1245	1270			
Sand			1270	1327			
Slate & Shell			1327	1365			
Sand			1365	1430			
Slate			1430	1464			
Sand			1464	1486			
Black Slate			1486	1499			
Slate			1499	1580			
Sand			1580	1600			
Black Slate			1600	1640			
Sandy Lime			1640	1681			
Third Salt			1681	1815			
Slate & Shell			1815	1855			
Maxon Sand			1855	1905			
Slate			1905	1920			
Hard Sand			1920	1940			
Lime			1940	1982			
Red Rock			1982	1985			
Slate			1985	1994			
Pencil			1994	1998			
Big Lime			1998	2055			
Hard Sand			2055	2074			
Soft Sand			2074	2085	Gas & Oil Show		
Hard Sand			2085	2110			
Sandy Lime			2110	2143			
Hard Sand			2143	2148			
Slate			2148	2158			
				Total Depth			

Date April 6, 1965
APPROVED Webber Assoc., Owner
By Jack E. Webber
(Title)