

Minimum Error of Closure $1'' = 200'$
 Source of Elevation USC & GS BMY-80 1943 EL. 812.49'
 "I, the undersigned, hereby certify that this map is correct to the best of my knowledge and belief and shows all the information required by paragraph 6 of the rules and regulations of the oil and gas section of the mining laws of West Virginia."

New Location.....
 Drill Deeper.....
 Abandonment.....

MAP SHEET 59, 5-11 W-5; F.B. 1310, P 32-34

Company HOPE NATURAL GAS CO.
 Address CLARKSBURG, W.VA.
 Farm ALFRED NEELEY
 Tract _____ Acres 300 Lease No. 17953
 Well (Farm) No. _____ Serial No. 10691
 Elevation (Spirit Level) 1001'
 Quadrangle CENTERPOINT S.W.
 County DODDRIDGE District GRANT
 Engineer Jackson M. Jarvis
 Engineer's Registration No. 2397
 File No. _____ Drawing No. _____
 Date 10-20-64 Scale 1" = 40 POLES

STATE OF WEST VIRGINIA
 DEPARTMENT OF MINES
 OIL AND GAS DIVISION
 CHARLESTON

WELL LOCATION MAP
 FILE NO. DOD-1205

+ Denotes location of well on United States Topographic Maps, scale 1 to 62,500, latitude and longitude lines being represented by border lines as shown.
 - Denotes one inch spaces on border line of original tracing.



STATE OF WEST VIRGINIA
DEPARTMENT OF MINES
OIL AND GAS DIVISION 5

Rotary
Spudder
Cable Tools
Storage

Quadrangle Centerpoint
Permit No. Dod-1205

WELL RECORD

Oil or Gas Well (Dry)
(KIND)

Company Consolidated Gas Supply Corp.
Address Clarksburg
Farm Alfred Neeley Acres 300
Location (waters) _____
Well No. 10691 Elev. 1001'
District Grant County Doddridge
The surface of tract is owned in fee by _____
Address _____
Mineral rights are owned by _____
Address _____
Drilling commenced _____
Drilling completed August 23, 1965
Date Shot Not Shot From _____ To _____
With _____

Casing and Tubing	Used in Drilling	Left in Well	Packers
Size			Kind of Packer
16			
13			Size of
10	384	384'	
8 1/4	1076	Pulled	Depth set
6 3/8			
5 3/16			
4 1/2	1946	1946	Perf. top
3			Perf. bottom
2			Perf. top
Liners Used			Perf. bottom


Open Flow /10ths Water in _____ Inch
/10ths Merc. in _____ Inch
Volume 59 M Cu. Ft.
Rock Pressure 35# lbs. 24 hrs. hrs.
Oil Show bbls., 1st 24 hrs.
WELL ACIDIZED (DETAILS) No
WELL FRACTURED (DETAILS) Yes

Attach copy of cementing record.
CASING CEMENTED 4 1/2" SIZE No. Ft. _____ Date _____
Amount of cement used (bags) 65 Bags
Name of Service Co. Halliburton
COAL WAS ENCOUNTERED AT 122 FEET 48 INCHES
FEET INCHES FEET INCHES
FEET INCHES FEET INCHES

RESULT AFTER TREATMENT (Initial open Flow or bbls.) 6 M
ROCK PRESSURE AFTER TREATMENT .35# HOURS 24
Fresh Water None Feet _____ Salt Water None Feet _____
Producing Sand Dry in Injun Depth _____

Dry Hole

Formation	Color	Hard or Soft	Top	Bottom	Oil, Gas or Water	Depth	Remarks
R. Rock & Sand							
Rocks			0	21			
Sand Rock			21	58			
Red Rock			58	63			
Slate			63	70			
Red Rock			70	92			
Lime			92	95			
Sand			95	122			
Coal			122	126			
Shale			126	131			
Sand			131	138			
Slate			138	145			
Lime			145	186			
Red Rock			186	190			
Lime			190	209			
R. Rock & Lime			209	218			
Lime			218	234			
Red Rock			234	237			
Sand			237	257			
Shale			257	262			
Sand			262	327			
Slate & Shells			327	382			
Lime			382	407			
Slate & Shells			407	452			
Sand			452	481			
Slate & Lime			481	500			
Red Rock			500	543			
Sand			543	565			
					WATER	150'	1 BLR HOUR

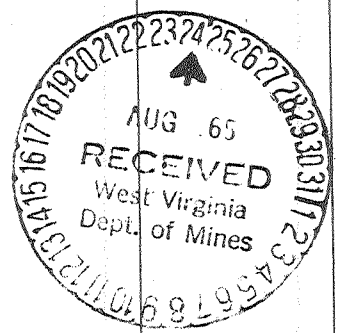

Formation	Color	Hard or Soft	Top 5'	Bottom	Oil, Gas or Water	Depth Found	Remarks
and Slate			565	581			
Rock & Slate			581	636			
Slate			636	670			
Lime			670	700			
Slate & Shells			700	716			
Lime			716	720			
Slate & Shells			720	734			
R. R.			734	785			
and Limey			785	812			
Slate & Shells			812	825			
and Lime			825	850			
Slate & Shells			850	862			
and			862	920			
Slate & Shells			920	960			
and			960	1055			
Slate & Shells			1055	1106			
and			1106	1175			
Slate			1175	1183			
Slate & Shells			1183	1278			
and			1278	1282			
Slate & Shells			1282	1371			
and 2nd Salt			1371	1401	WATER	1333	
Slate & Shells			1401	1409			
and Broken			1409	1525			
and 3rd Salt			1525	1545			
Slate			1545	1555			
and			1555	1577			
Slate & Shells			1577	1580			
Sandy Slate			1580	1661			
and Maxton			1661	1682			
Slate			1682	1715			
Little Lime			1715	1760	GAS	BLUE MONDAY	
Blue Monday			1760	1797			
Big Lime			1797	1918	GAS	INJUN	
Big Injun			1918	1966			
Slate							
TOTAL DEPTH				1966			

Date AUGUST 23, 1965, 19

APPROVED CONSOLIDATED GAS SUPPLY CORPORATION, Owner

By *Jack Bulley*
(Title)