

New Location
 Drill Deeper
 Abandonment

Elev. Well No 1 - 858.1
 Error in Closure :- Less than 1' in 200

Company James F. Scott
 Address 124 Valley St., Salem, W. Va.
 Farm G. W. Fleming
 Tract _____ Acres 70 Lease No. _____
 Well (Farm) No. Two Serial No. _____
 Elevation (Spirit Level) 1142'
 Quadrangle Centurpoint - C
 County Doddridge District McClellan
 Engineer W. Stoltz
 Engineer's Registration No. 1227
 File No. _____ Drawing No. _____
 Date April 25, 1965 Scale 1" = 30p = 495'

STATE OF WEST VIRGINIA
 DEPARTMENT OF MINES
 OIL AND GAS DIVISION
 CHARLESTON

WELL LOCATION MAP
 FILE NO. DOD - 1252

+ Denotes location of well on United States Topographic Maps, scale 1 to 62,500, latitude and longitude lines being represented by border lines as shown.
 - Denotes one inch spaces on border line of original tracing.

66 99



STATE OF WEST VIRGINIA
DEPARTMENT OF MINES
OIL AND GAS DIVISION

10-7-65
10

Quadrangle Centerpoint

Permit No. DOD-1252

WELL RECORD

Oil or Gas Well Gas
(KIND)

Company James F. Scott
Address 124 Valley St., Salem, West Va.
Farm G. W. Fleming Acres 70
Location (waters) Pike Fork
Well No. 2 Elev. 1142
District McClellan County Doddridge
The surface of tract is owned in fee by C. James
Route 2 Address Salem, W. Va.
Mineral rights are owned by Edison E. Ritter &
James F. Scott Address Salem, W. Va.
Drilling commenced July 28, 1965
Drilling completed September 2, 1965
Date Shot _____ From _____ To _____
With _____

Casing and Tubing	Used in Drilling	Left in Well	Packers
Size			Kind of Packer
16			
13			
10			Size of
8 1/4	1197		
7"	1704	1704	Depth set
5 3/16	2183	2183	
3			Perf. top 2052
2			Perf. bottom 2067
Liners Used			Perf. top 2118
			Perf. bottom 2126

Open Flow _____ /10ths Water in _____ Inch
_____ /10ths Merc. in _____ Inch
Volume 84,000 Cu. Ft.
Rock Pressure Unknown lbs. _____ hrs.
Oil _____ bbls., 1st 24 hrs.
WELL ACIDIZED _____

CASING CEMENTED 5 1/2 SIZE 2183 No. Ft. 9/2/65 Date

COAL WAS ENCOUNTERED AT _____ FEET _____ INCHES
_____ FEET _____ INCHES _____ FEET _____ INCHES
_____ FEET _____ INCHES _____ FEET _____ INCHES


WELL FRACTURED 33,600 gal water and 25,000 lbs. sand at 21 bbl. per min.

RESULT AFTER TREATMENT 280,000 cu. ft.

ROCK PRESSURE AFTER TREATMENT 500

Fresh Water _____ Feet _____ Salt Water _____ Feet _____

Formation	Color	Hard or Soft	Top	Bottom	Oil, Gas or Water	Depth	Remarks
top soil			0	5			
blue clay			5	15			
red rock			15	30			
sand			30	65			
red rock			65	100			
slate			100	150			
sand			150	310			
sandy slate			310	360			
sand			360	390			
slate			390	420			
lime rock			420	427			
red rock			427	430			
lime			430	520			
slate shells			520	610			
lime hard			610	615			
slate & shells			615	670			
black slate			670	677			
slate & shells			677	752			
sand			752	785			
slate			785	805			
lime			805	815			
sand			815	830			
lime			830	855			
red rock			855	920			
slate & shells			920	955			
red rock			955	980			
slate			980	985			
lime			985	1033			
slate & shells			1033	1040			
black slate			1040	1047			

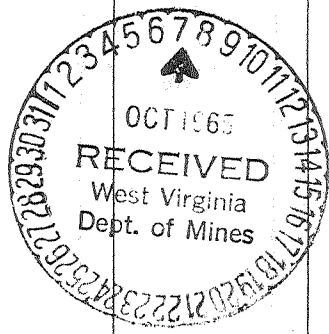

Formation	Color	Hard or Soft	Top	Bottom	Oil, Gas or Water	Depth Found	Remarks
slate & shells			1047	1142			
pink rock			1142	1165			
slate			1165	1195			
lime			1195	1240			
red rock			1240	1250			
and			1250	1370			
lime			1370	1405			
and			1405	1442			
lime			1442	1451			
and			1451	1500			
lime			1500	1535			
slate gray			1535	1570			
black slate			1570	1575			
and			1575	1614			
slate & shells			1614	1710			
lime gritty			1710	1728			
slate & shells			1728	1750			
lime			1750	1770			
slate			1770	1785			
red rock			1785	1828			
red rock			1828	1916			
black slate			1916	1945			
lime			1945	2044			
and			2044	2139			
slate			2139	2190			

Date OCTOBER 4, 1965
 APPROVED James F. Scott, Owner
 By _____ (Title)