

I, the undersigned, hereby certify that this map is correct to the best of my knowledge and belief and that all of the information contained herein is true and correct as far as the same is a matter of fact and is not a matter of opinion.

*W. H. Stewart*  
A. E. L. No.

New Location   
 Drill Deeper   
 Abandonment

Elev. forks of road = 838'  
 Error in Closure: - Less than 1' in 200

Company MARKET OIL & GAS CO.  
 Address 4 Clarence Powell, West Union, W. Va.  
 Farm Grover Johnson, et al  
 Tract \_\_\_\_\_ Acres 40 Lease No. \_\_\_\_\_  
 Well (Farm) No. One Serial No. \_\_\_\_\_  
 Elevation (Spirit Level) 918'  
 Quadrangle Vadis - NW  
 County Doddridge District New Milton  
 Engineer W. H. Stewart  
 Engineer's Registration No. 1227  
 File No. \_\_\_\_\_ Drawing No. \_\_\_\_\_  
 Date Aug 5, 1965 Scale 1" = 300' = 495'

STATE OF WEST VIRGINIA  
 DEPARTMENT OF MINES  
 OIL AND GAS DIVISION  
 CHARLESTON

WELL LOCATION MAP  
 FILE NO. 000-1395

+ Denotes location of well on United States Topographic Maps, scale 1 to 62,500, latitude and longitude lines being represented by border lines as shown.  
 - Denotes one inch spaces on border line of original tracing.

6-0 144



STATE OF WEST VIRGINIA  
DEPARTMENT OF MINES  
OIL AND GAS DIVISION

Quadrangle Vadis  
Permit No. DOD -1295

**WELL RECORD**

Oil or Gas Well Dry  
(MND)

Company Market Oil & Gas Co. Inc.  
Address C. Powell, West Union, W. Va.  
Farm Grover Johnson Acres 40  
Location (waters) Thomas Fork  
Well No. 1 Elev. 918  
District New Milton County Doddridge  
The surface of tract is owned in fee by Grover Johnson  
Address West Union, W. Va.  
Mineral rights are owned by L. Maxwell Heirs & Grover Johnson  
Address West Union, W. Va.  
Drilling commenced August 25, 1965  
Drilling completed September 22, 1965  
Date Shot \_\_\_\_\_ From \_\_\_\_\_ To \_\_\_\_\_  
With \_\_\_\_\_  
Open Flow /10ths Water in \_\_\_\_\_ Inch  
/10ths Merc. in \_\_\_\_\_ Inch  
Volume NO Cu. Ft.  
Rock Pressure \_\_\_\_\_ lbs. \_\_\_\_\_ hrs.  
Oil \_\_\_\_\_ bbls., 1st 24 hrs.  
WELL ACIDIZED \_\_\_\_\_  
WELL FRACTURED \_\_\_\_\_

Casing and Tubing	Used in Drilling	Left in Well	Packers
Size	<b>12ft</b>		
16			Kind of Packer _____
13			
10	<u>277ft</u>		Size of _____
8 1/4	<u>1184ft</u>		
6 5/8			Depth set _____
5 3/16			
3			Perf. top _____
2			Perf. bottom _____
Liners Used			Perf. top _____
			Perf. bottom _____


CASING CEMENTED \_\_\_\_\_ SIZE \_\_\_\_\_ No. Ft. \_\_\_\_\_ Date \_\_\_\_\_  
COAL WAS ENCOUNTERED AT \_\_\_\_\_ FEET \_\_\_\_\_ INCHES  
\_\_\_\_\_ FEET \_\_\_\_\_ INCHES FEET \_\_\_\_\_ INCHES  
\_\_\_\_\_ FEET \_\_\_\_\_ INCHES FEET \_\_\_\_\_ INCHES

RESULT AFTER TREATMENT \_\_\_\_\_  
ROCK PRESSURE AFTER TREATMENT \_\_\_\_\_

*Next Sheet*

Fresh Water \_\_\_\_\_ Feet \_\_\_\_\_ Salt Water \_\_\_\_\_ Feet \_\_\_\_\_

Formation	Color	Hard or Soft	Top	Bottom	Oil, Gas or Water	Depth	Remarks
Sand			0	10			
Red Rock			10	25			
White Clay			25	80			
Lime			80	90			
Slate	White		90	98			
Red Rock			98	155			
Sand			155	160			
Red Rock			160	232			
Sand			232	246			
Red Rock			246	355			
Slate&Shells			355	455			
Sand			455	485			
Slate&Shells			485	660			
Sand			660	683			
Slate	White		683	695			
Lime			695	720			
Red Rock			720	745			
Slate			745	755			
Lime			755	775			
Red Rock			775	840			
Sand			840	854			
Hard Lime			854	875			
Slate&Shells			875	995			
Sand			995	1025			
Slate&Shells			1025	1100			
Sand			1100	1115			
Slate	White		1115	1125			
Slate			1125	1145			
Sand			1145	1190			
Slate&Shells			1190	1240			

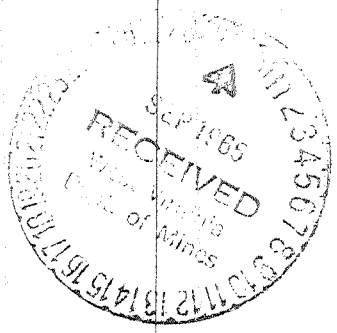

Formation	Color	Hard or Soft	Top <sup>6</sup>	Bottom	Oil, Gas or Water	Depth Found	Remarks
Sand	Green		1240	1255			
Slate			1255	1264			
Sand			1264	1296			
Slate	Black		1296	1398			
Sand			1398	1423			
Slate			1423	1440			
Sand			1440	1517			
Slate & Shells			1517	1652			
Sand			1652	1744			
Slate			1744	1790			
Lime			1790	1822			
Slate & Shells			1822	1910			
Lime			1910	1935			
Slate			1935	1950			
Sand			1950	1985			
Big Lime			1985	2038	Gas	1970 to 1974	
Sand (Injun)			2038	2120			
Slate			2120	2149			
Slate			2149	2160			
	Total Depth		2160				

Date September 29, 1965

APPROVED Market Oil & Gas Co. Inc., Owner  
Clarence Powell, Agt.  
By \_\_\_\_\_ (Title)