

"I, THE UNDERSIGNED, HEREBY CERTIFY THAT THIS MAP IS CORRECT TO THE BEST OF MY KNOWLEDGE AND BELIEF AND SHOWS ALL THE INFORMATION REQUIRED BY PARAGRAPH 6 OF THE RULES AND REGULATIONS OF THE OIL AND GAS SECTION OF THE MINING LAWS OF WEST VIRGINIA."

By Paul H. Dean

New Location.....
 Drill Deeper.....
 Abandonment.....


B. M. REF. = ROAD INTERSECTION AT CLAYLICK SCHOOL 1 1/2 MI. S.W. OF LOC.
 MINIMUM ERROR OF CLOSURE 1/2,000

Company MANN DRILLING CO.
 Address Box 86, CLARKSBURG, W.VA.
 Farm LEWIS MAXWELL
 Tract 1 Acres 900± Lease No. _____
 Well (Farm) No. (21) Serial No. _____
 Elevation (Spirit Level) 940
 Quadrangle WEST UNION - SE
 County DODDRIEGE District CENTRAL
 Engineer Paul H. Dean
 Engineer's Registration No. 1056
 File No. 136-5-3020 Drawing No. 65-53
 Date SEPT. 20, 1965 Scale 1" = 500'

STATE OF WEST VIRGINIA
 DEPARTMENT OF MINES
 OIL AND GAS DIVISION
 CHARLESTON

WELL LOCATION MAP
 FILE NO. DOD-1328

+ Denotes location of well on United States Topographic Maps, scale 1 to 62,500, latitude and longitude lines being represented by border lines as shown.
 - Denotes one inch spaces on border line of original tracing.

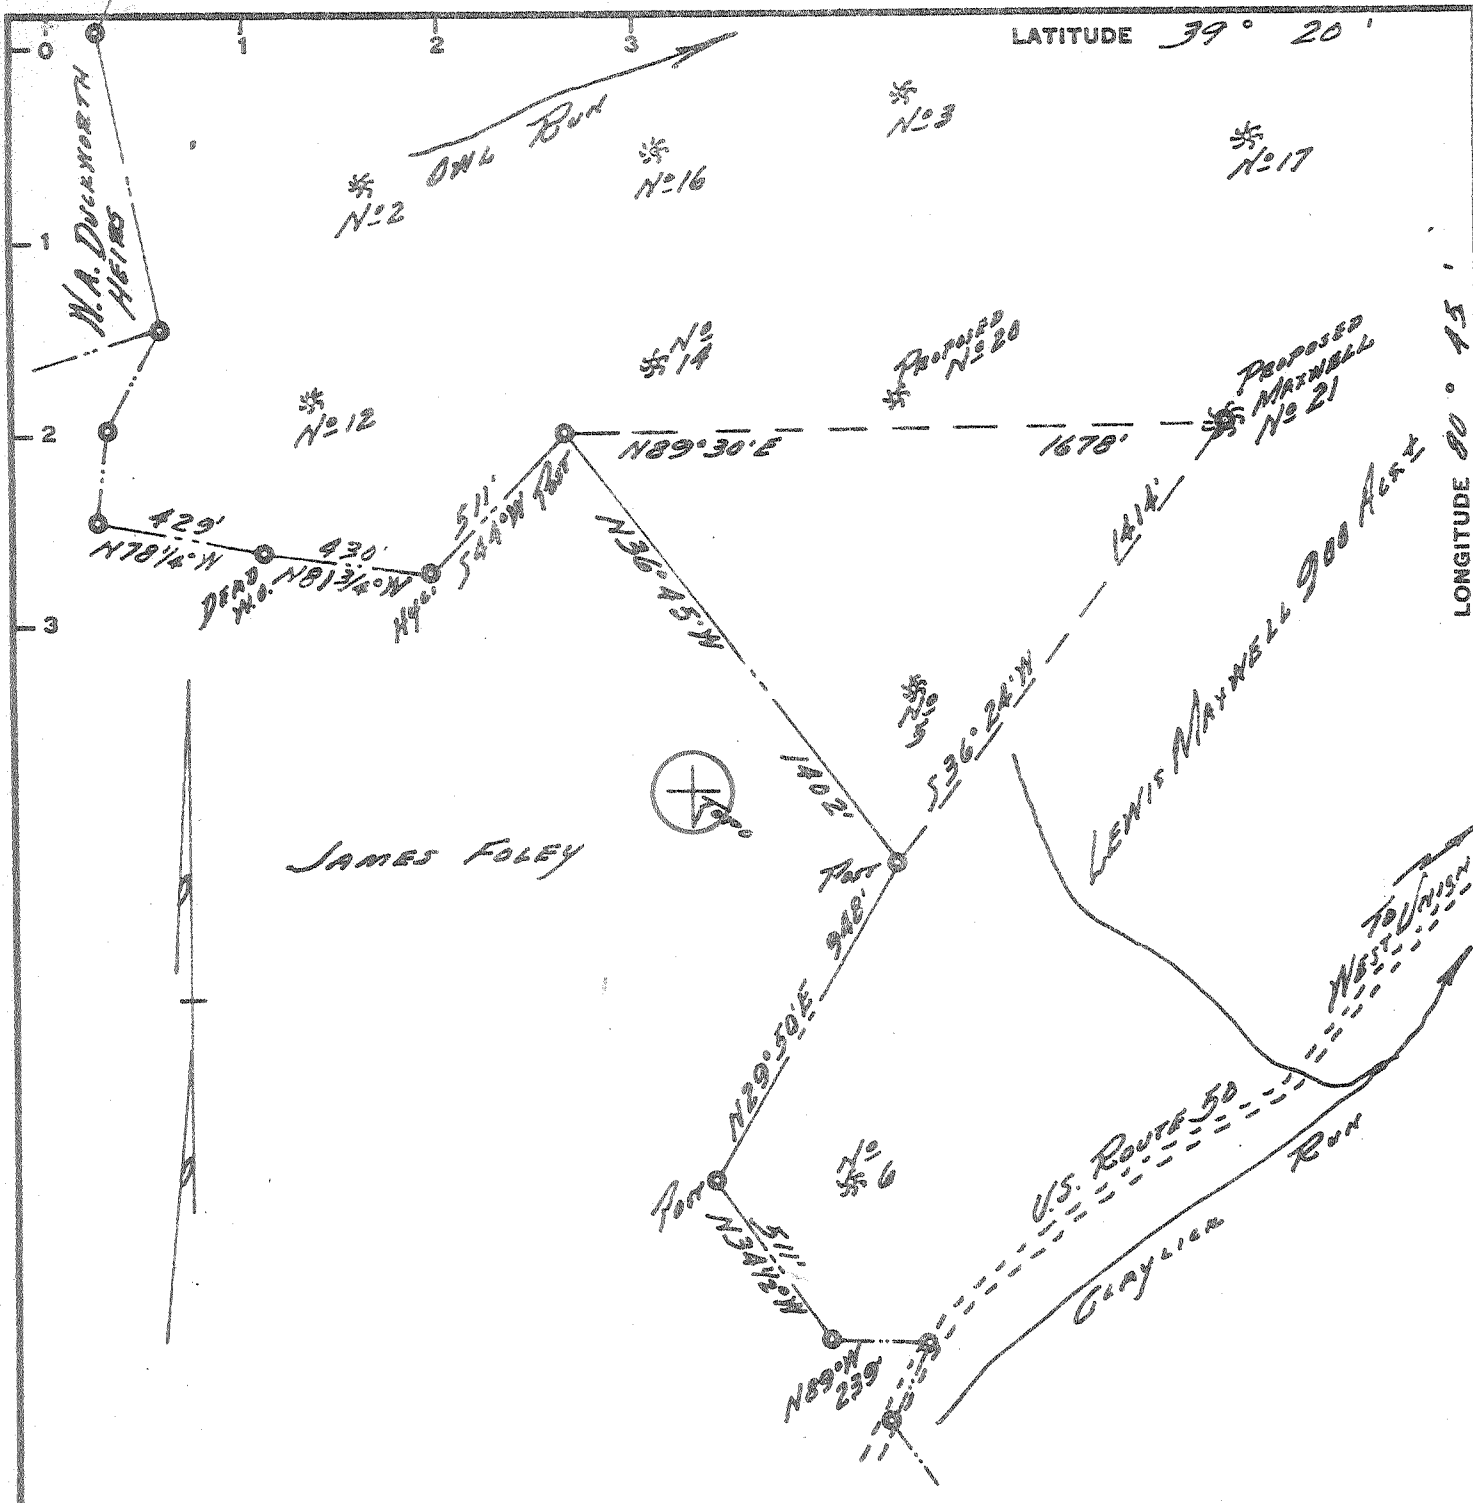

JAMES FOLEY

I HEREBY CERTIFY THAT THIS LOCATION IS CORRECT TO THE BEST OF MY KNOWLEDGE AND BELIEF AND THAT I HAVE THE INFORMATION REQUIRED BY REGULATIONS OF THE DEPARTMENT OF MINES AND GEOLOGICAL SURVEY AND THE MINING LAWS OF WEST VIRGINIA.

Paul H. Dean

- New Location
- Drill Deeper
- Abandonment

B.M. REF: ROAD INTERSECTION AT CLAYLICK SCHOOL 1 1/2 MI. S.W. OF LOC. MINIMUM ERROR OF CLOSURE 1/2,000

Company	MANN DRILLING CO.
Address	Box 86, CLARKSBURG, W.VA.
Farm	LEWIS MAXWELL
Tract	1 Acres 900± Lease No. _____
Well (Farm) No.	21 Serial No. _____
Elevation (Spirit Level)	940
Quadrangle	WEST UNION SE
County	DODDGE District CENTRAL
Engineer	Paul H. Dean
Engineer's Registration No.	1856
File No.	136-5-3022 Drawing No. 65-53
Date	SEPT. 20, 1965 Scale 1" = 500'

STATE OF WEST VIRGINIA
DEPARTMENT OF MINES
OIL AND GAS DIVISION
CHARLESTON

WELL LOCATION MAP
FILE NO. 1004-1328
DRILLING CANCELED

+ Denotes location of well on United States Topographic Maps, scale 1 to 62,500, latitude and longitude lines being represented by border lines as shown.

- Denotes one inch spaces on border line of original tracing.

SEP 11 1978