


10  
1965  
1966

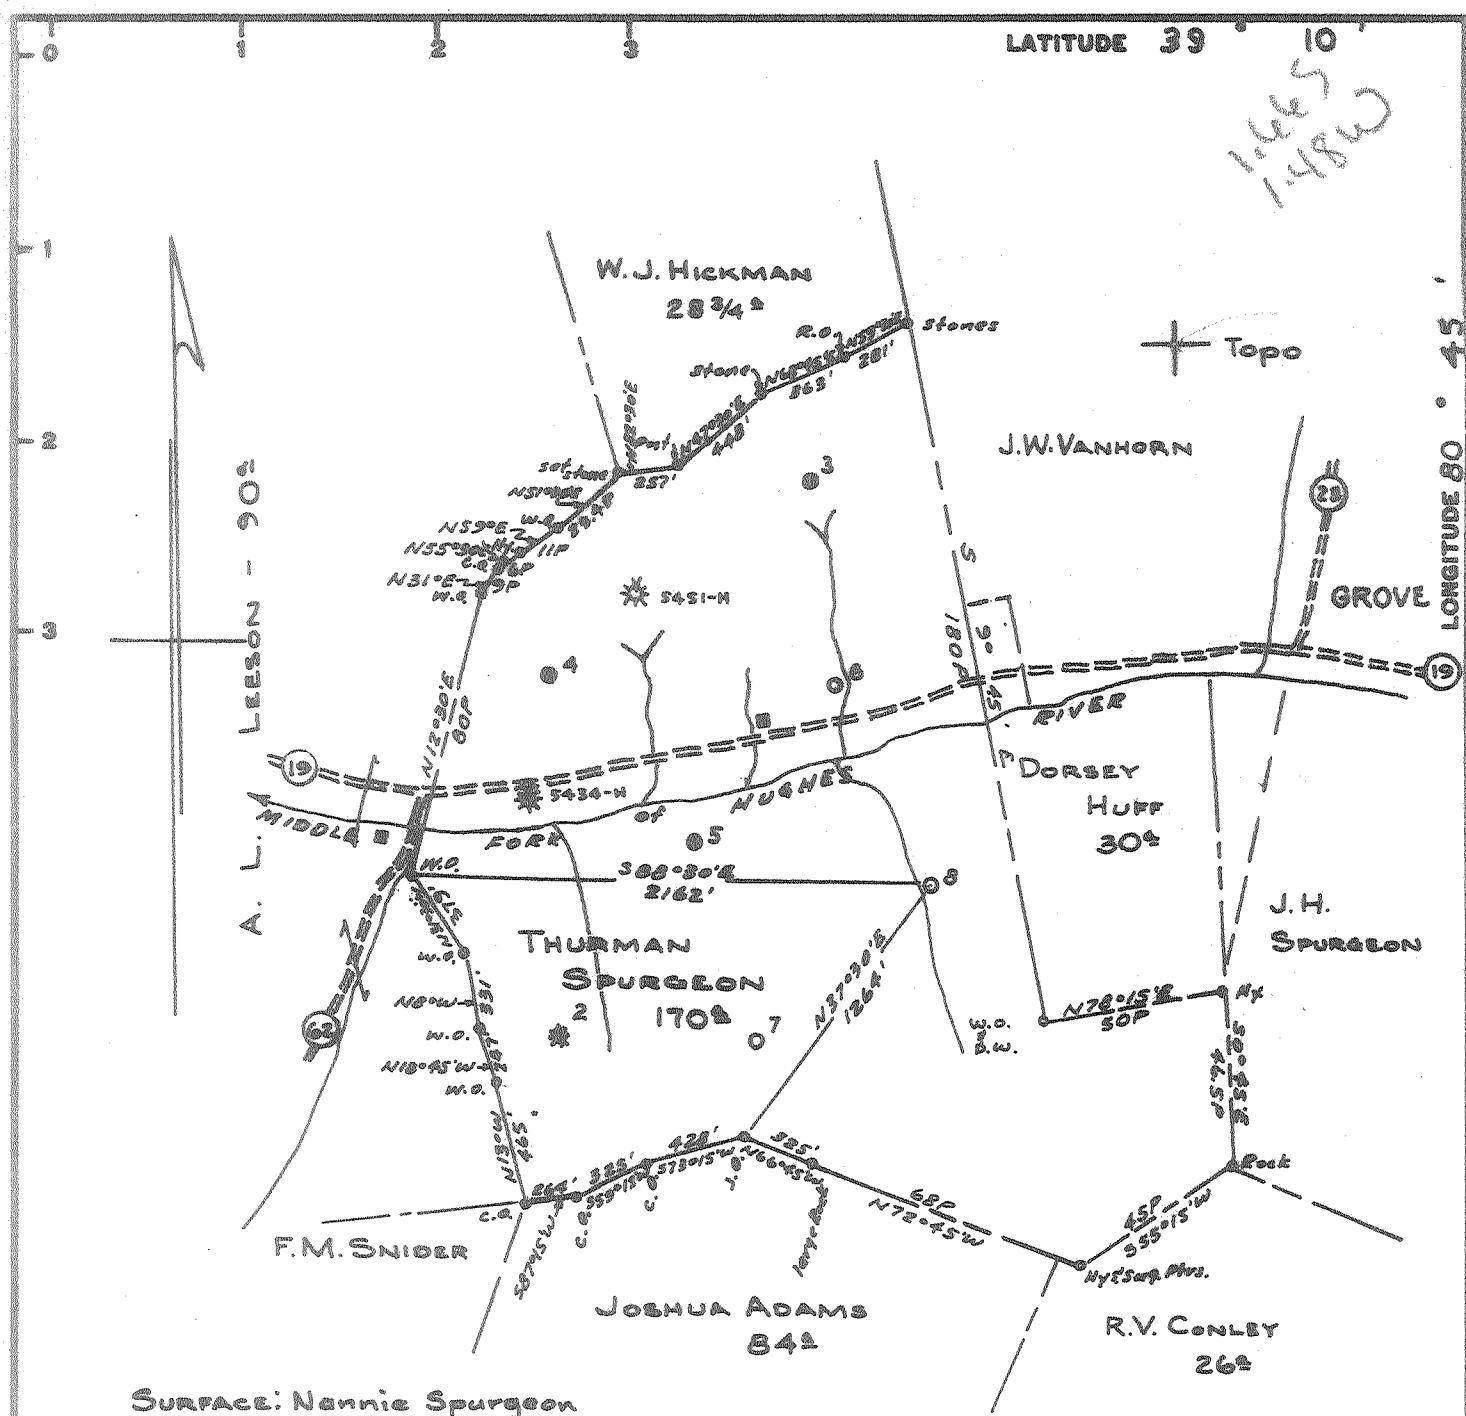

SURFACE: Nannie Spurgeon  
Auburn, W.Va.

Coal: No Commercial Coal.

Minimum Error of Closure 1' in 200'

Source of Elevation H.N.G.C. Well # 5434-H (Abd. Permit

Dodd. 1052-A) Elev. 875' ground.

I, the undersigned, hereby certify that this map is correct to the best of my knowledge and belief and shows all the information required by paragraph 6 of the rules and regulations of the oil and gas section of the mining laws of West Virginia.

Signed: A.C. Hibbert

Map No. 647 Squares: N S 21 E W 9-10

Company	PENNZOIL COMPANY		
Address	P. O. BOX 1588, PARKERSBURG, W. VA.		
Farm	THURMAN SPURGEON		
Tract	Acres 170 <sup>2</sup>	Lease No.	71767
Well (Farm) No.	<u>8</u>	Serial No.	
Elevation (Spirit Level)	905.70' ground.		
Quadrangle	HOLBROOK - EC		
County	DODDRIDGE District COVE		
Engineer	<u>A.C. Hibbert</u>		
Engineer's Registration No.	2534		
File No.	1416	Drawing No.	
Date	Oct. 7, 1965		
Scale	1" = 800'		

STATE OF WEST VIRGINIA  
DEPARTMENT OF MINES  
OIL AND GAS DIVISION  
CHARLESTON

### WELL LOCATION MAP

FILE NO. Dod - 1320

Kla 7/13/94

Canc 10/21/1965 DEP database

+ Denotes location of well on United States Topographic Maps, scale 1 to 62,500, latitude and longitude lines being represented by border lines as shown.

- Denotes one inch spaces on border line of original tracing.