

New Location.....  
 Drill Deeper.....  
 Abandonment.....

Elev. ref.: - Well No 3 = 1249'  
 Error in Closure: - Less than 1' in 300'

*W. H. H. J.*

Company CREST OIL CO.  
 Address P.O. Box 57, Alton, Illinois  
 Farm Henry A' Hausus Hrs.  
 Tract \_\_\_\_\_ Acres 50 Lease No. \_\_\_\_\_  
 Well (Farm) No. Four Serial No. \_\_\_\_\_  
 Elevation (Spirit Level) 1291 ELLW 1220-KL2  
1112-190-75'+200  
 Quadrangle Kadis - WC  
 County Doddridge District New Milton  
 Engineer W. H. H. J.  
 Engineer's Registration No. 1227  
 File No. \_\_\_\_\_ Drawing No. \_\_\_\_\_  
 Date Oct. 30, 1965 Scale 1" = 300' = 495'

STATE OF WEST VIRGINIA  
 DEPARTMENT OF MINES  
 OIL AND GAS DIVISION  
 CHARLESTON

WELL LOCATION MAP  
 FILE NO. 000-1341

+ Denotes location of well on United States Topographic Maps, scale 1 to 62,500, latitude and longitude lines being represented by border lines as shown.

- Denotes one inch spaces on border line of original tracing.



STATE OF WEST VIRGINIA  
DEPARTMENT OF MINES  
OIL AND GAS DIVISION

*Miss Phillips  
for problem  
5-12-66*

Rotary   
Spudder   
Cable Tools   
Storage

Quadrangle Vadis

WELL RECORD

Oil or Gas Well Oil (KIND)

Permit No. DODD-1341

Company Crest Oil Company  
Address P. O. Box 57 Alton, Illinois  
Farm Henry Ahouse Acres 50  
Location (waters) Brushy Fork Elev. 1220' - 1212' Size 16"  
Well No. 4 Elev. 1237' 5"  
District New Milton County Doddridge  
The surface of tract is owned in fee by O. C. Haught and Cumpston heirs Address New Milton, W. Va.  
Mineral rights are owned by Same Address \_\_\_\_\_


Casing and Tubing	Used in Drilling	Left in Well	Packers
18"			Kind of Packer _____
10"			Size of _____
8 1/4"	1229	25	Depth set _____
6 3/4"	2282	32	
5 1/2" 16 lbs	2460	2460	
3"			Perf. top _____
2"			Perf. bottom _____
Liners Used _____			Perf. top _____
			Perf. bottom _____

Drilling commenced December 30, 1965  
Drilling completed April 4, 1966  
Date Shot \_\_\_\_\_ From \_\_\_\_\_ To \_\_\_\_\_  
With \_\_\_\_\_  
Open Flow \_\_\_\_\_ /10ths Water in \_\_\_\_\_ Inch  
\_\_\_\_\_ /10ths Merc. in \_\_\_\_\_ Inch  
Volume \_\_\_\_\_ Cu. Ft.  
Rock Pressure \_\_\_\_\_ lbs. \_\_\_\_\_ hrs.  
Oil Show \_\_\_\_\_ bbls., 1st 24 hrs.  
WELL ACIDIZED \_\_\_\_\_

CASING CEMENTED 2460 SIZE 4-1/2 No. Ft. 3/28/66 Date  
Lawson 50 sacks high early  
COAL WAS ENCOUNTERED AT \_\_\_\_\_ FEET \_\_\_\_\_ INCHES  
\_\_\_\_\_ FEET \_\_\_\_\_ INCHES \_\_\_\_\_ FEET \_\_\_\_\_ INCHES  
\_\_\_\_\_ FEET \_\_\_\_\_ INCHES \_\_\_\_\_ FEET \_\_\_\_\_ INCHES

WELL FRACTURED 4/6/66, Dowell, 445 bbls Oil 16,000 lbs sand 1000 gals mud acid  
RESULT AFTER TREATMENT Swab test after 14 days clean up, 20 bbls 24 hrs. *Big Injia*  
ROCK PRESSURE AFTER TREATMENT 750 psi 72 hrs.  
Fresh Water \_\_\_\_\_ Feet \_\_\_\_\_ Salt Water \_\_\_\_\_ Feet \_\_\_\_\_

Formation	Color	Hard or Soft	Top	Bottom	Oil, Gas or Water	Depth	Remarks
Mud			0	5			
Clay			5	10			
Red Rock			10	21			
Sand			21	40			
Red			40	68			
Sand			68	75			
Slate	Grey		75	86			
Slate	Grey		86	90			
Sand			90	120			
Slate			120	130			
Red Rock			130	150			
Slate			150	185			
Red Rock			185	200			
Slate			200	245			
Red Rock			245	280			
Red Rock and Shells			280	366			
Lime			366	381			
Slate & Shells			381	395			
Slate	Black		395	400			
Slate	Grey		400	415			
Lime			415	470			
Red Rock			470	495			
Sand			495	525			
Red Rock and Shells			525	545			
Lime			545	560			
Red Rock			560	615			
Lime			615	642			
Slate	Grey		642	655			

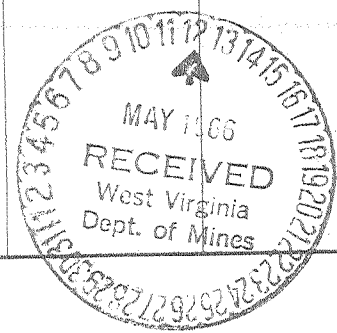

Formation	Color	Hard or Soft	Top	Bottom	Oil, Gas or Water	Depth Found	Remarks
Red Rock			655	708			
Red Rock & Shells			708	765			
Slate			765	770	Water	775	Fresh, 30 gal/hr
Sand			770	925			
Lime & Shells			925	955			
Slate	Black		955	970			
Slate	White		970	980			
Slate & Shells			980	990			
Sand		Hard	990	1037			
Slate			1037	1055			
Red Rock			1055	1090			
Lime & Shells			1090	1120			
Red Rock & Shells			1120	1227			
Lime			1227	1229			
Slate & Shells			1229	1265			
Lime			1265	1285			
Sandy-Lime			1285	1297			
Slate			1297	1310			
Slate & Pink Rock			1310	1340			
Slate			1340	1365			
Sandy-Slate & Shells			1365	1380			
Sandy-Lime			1380	1400			
Sand			1400	1471			
Sandy-Lime			1471	1514			
Sand			1514	1565			
Sandy-Lime			1565	1575			
Slate & Shells			1575	1610			
Slate	Gray		1610	1640			
Lime	Gray		1640	1650			
Lime			1650	1660			
Sandy-Lime			1660	1685			
Slate			1685	1739			
Lime	Gray		1739	1760			
Shale	Gray		1760	1765			
Sand	Gray	Hard	1765	1824			
Sandy-Lime			1824	1836			
Slate	Black and Sandy shells		1836	1941			
Salt Sand			1941	1993			
Slate	Gray		1993	2051			
Slate	Black (Streaks of Lime)		2051	2145			
Slate	Black (Lime Shells)		2145	2150			
Red Rock & Shells			2150	2190			
Red Rock			2190	2260			
Slate			2260	2270			
Lime			2270	2285			
Slate			2285	2315			
Lime	Blue		2315	2333			
Red Rock			2333	2337			
Blue-Monday Sd.			2337	2370			
Big Lime			2370	2413			
Big Injun Sd.			2413	2484			
<b>Total Depth</b>			<b>2484</b>				Oil in sand(2467-2475)

Date MAY 10, 1966

APPROVED CREST OIL COMPANY, Owner

By C. F. Swain  
(Title)

C. F. SWAIN, OWNER