

ACCURACY: 1p / 200p

Source of Elevation B. M. @ CENTERPOINT (790')

- New Location
- Drill Deeper
- Abandonment
- Fracture
- Redrill

I, the undersigned, hereby certify that this map is correct to the best of my knowledge and belief and shows all the information required by paragraph 6 of the rules and regulations of the oil and gas section of the mining laws of West Virginia.

*Chet Waterman*

Company	T. W. M. PETROLEUM, INC.		
Address	CLARKSBURG, W. VA.		
Farm	C. DAVIS		
Tract	Acres	69.6	Lease No.
Well (Farm) No.	1	Serial No.	
Elevation (Spirit Level)	804'		
Quadrangle	CENTERPOINT - C		
County	DODDRIDGE	District	MCCLELLAN
Engineer	CHET WATERMAN		
Engineer's Registration No.	3788		
File No.	66003-61	Drawing No.	
Date	4/26/66	Scale	1" = 20p

STATE OF WEST VIRGINIA  
DEPARTMENT OF MINES  
OIL AND GAS DIVISION  
CHARLESTON

WELL LOCATION MAP  
FILE NO. DOD -1376

+ Denotes location of well on United States Topographic Maps, scale 1 to 62,500, latitude and longitude lines being represented by border lines as shown.

-- Denotes one inch spaces on border line of original tracing.

6-0 99



STATE OF WEST VIRGINIA  
DEPARTMENT OF MINES  
OIL AND GAS DIVISION 2

Quadrangle Centerpoint  
Permit No. 1376

WELL RECORD

Dry  
Oil or Gas Well (KIND)

Company TWM Petroleum, Inc.  
Address 912-A Goff Bldg., Clarksburg, W. Va.  
Farm C. Davis #1 Unit Acres 69.4  
Location (waters) Robinson Fork  
Well No. 1 Elev. 804  
District McClellan County Doddridge  
The surface of tract is owned in fee by Chancie Davis  
Address Salem, W. Va.  
Mineral rights are owned by Chancie Davis et al  
Address scattered  
Drilling commenced May 11, 1966  
Drilling completed May 16, 1966  
Date Shot \_\_\_\_\_ From \_\_\_\_\_ To \_\_\_\_\_  
With \_\_\_\_\_  
Open Flow \_\_\_\_\_ /10ths Water in \_\_\_\_\_ Inch  
\_\_\_\_\_ /10ths Merc. in \_\_\_\_\_ Inch  
Volume Rotary hole - no shows Cu. Ft.  
Rock Pressure \_\_\_\_\_ lbs. \_\_\_\_\_ hrs.  
Oil \_\_\_\_\_ bbls., 1st 24 hrs.  
WELL ACIDIZED \_\_\_\_\_

Casing and Tubing	Used in Drilling	Left in Well	Packers
Size			Kind of Packer
16			
13			
10			Size of
8 5/8	462'	none	Depth set
8 1/2			
6 5/8			
5 3/16	1950'	470'	6 Perf. top 1839
4 1/2			Perf. bottom 1843
2			1871
			8 Perf. top 1875
			Perf. bottom

CASING CEMENTED 1 1/2 SIZE 1950 No. Ft. \_\_\_\_\_

COAL WAS ENCOUNTERED AT \_\_\_\_\_ FEET \_\_\_\_\_ INCHES  
\_\_\_\_\_ FEET \_\_\_\_\_ INCHES FEET \_\_\_\_\_ INCHES  
\_\_\_\_\_ FEET \_\_\_\_\_ INCHES FEET \_\_\_\_\_ INCHES


WELL FRACTURED Used 800 bbls. water, 35,000# sand, 500 gals. acid, 110,000 SCF Nitrogen.

RESULT AFTER TREATMENT none

ROCK PRESSURE AFTER TREATMENT

Fresh Water \_\_\_\_\_ Feet \_\_\_\_\_ Salt Water \_\_\_\_\_ Feet

Formation	Color	Hard or Soft	Top	Bottom	Oil, Gas or Water	Depth	Remarks
Shale & Sand			0	76			
Shale & Sand			76	185			
Lime & Sand			185	305			
Shale & shells			305	420			
Coal			420	425			
Shale & Sand			425	462			
Shale			462	495			
Sand			495	505			
Lime, shale, sand & shale			505	634			
Red bed			634	680			
Sand & shale, lime			680	835			
Shale & sand			835	905			
Sand			905	948			
Sand & shale			948	970			
Sand			970	1120			
Sand & shale, shaley lime			1120	1225			
Shale & sand			1225	1230			
Shale & lime			1230	1235			
Sand			1235	1285			
Lime			1285	1290			
Sand & lime streaks			1290	1355			
Sand			1355	1415			
Shale & sand			1415	1430			
Sand			1430	1459			
Sand & shale (gritty lime)			1459	1480			
Shale & light sand trace			1480	1520			
Sandy lime			1520	1559			
Sand			1559	1579			
Sand & lime			1579	1680			
Sand & shale, shaley lime			1680	1710			

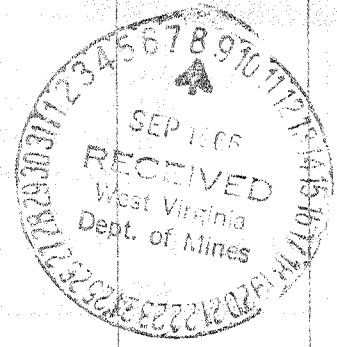

Formation	Color	Hard or Soft	Top <sup>2</sup>	Bottom	Oil, Gas or Water	Depth Found	Remarks
Lime (big lime)			1710	1780			
Shaley sand & sand			1780	1793			
Shale & sandy shale			1793	1800			
Shaley sand & sand			1800	1815			
Sand-shaley			1815	1957			
Sandy shale w/lime streaks			1957	2000			
				2000 T.D.			

Date Sept 13, 1946

APPROVED W.M. Petroleum Inc., Owner

By H. H. Siddle Eng'r  
(Title)