

I, the undersigned, hereby certify that this map is correct to the best of my knowledge and belief and shows all of the information required by paragraph 6 of the rules and regulations of the oil and gas section of the mining laws of West Virginia.

W. P. E. No. 122
E. P. E. No. 122

View Location
Drill Deeper
Abandonment 4-8-74

Elev. ref: - Elev. at mo. of Buckeye = 890'
Error in Closure less than 1 in 200'


STONESTREET LANDS COMPANY	
Company	JAMES F. SCOTT
Address	Box 50, Spencer, W Va. 25276
Farm	124 Valley St. Suburb West Va Formerly J. M. Ross *(Kenneth Chumley)
Tract	Acres 63 Lease No. _____
Well (Farm) No.	Ops _____ Serial No. _____
Elevation (Spirit Level)	1157
Quadrangle	Vadis NC
County	Doddridge District Greenbrier
Engineer	<i>W. P. E. No. 122</i>
Engineer's Registration No.	1227
File No.	Drawing No. _____
Date	June 3 1966 Scale 1" = 200' = 495'

STATE OF WEST VIRGINIA
DEPARTMENT OF MINES
OIL AND GAS DIVISION
CHARLESTON

WELL LOCATION MAP
FILE NO. DOD - 1385 - P

+ Denotes location of well on United States Topographic Maps, scale 1 to 62,500, latitude and longitude lines being represented by border lines as shown.

- Denotes one inch spaces on border line of original tracing.

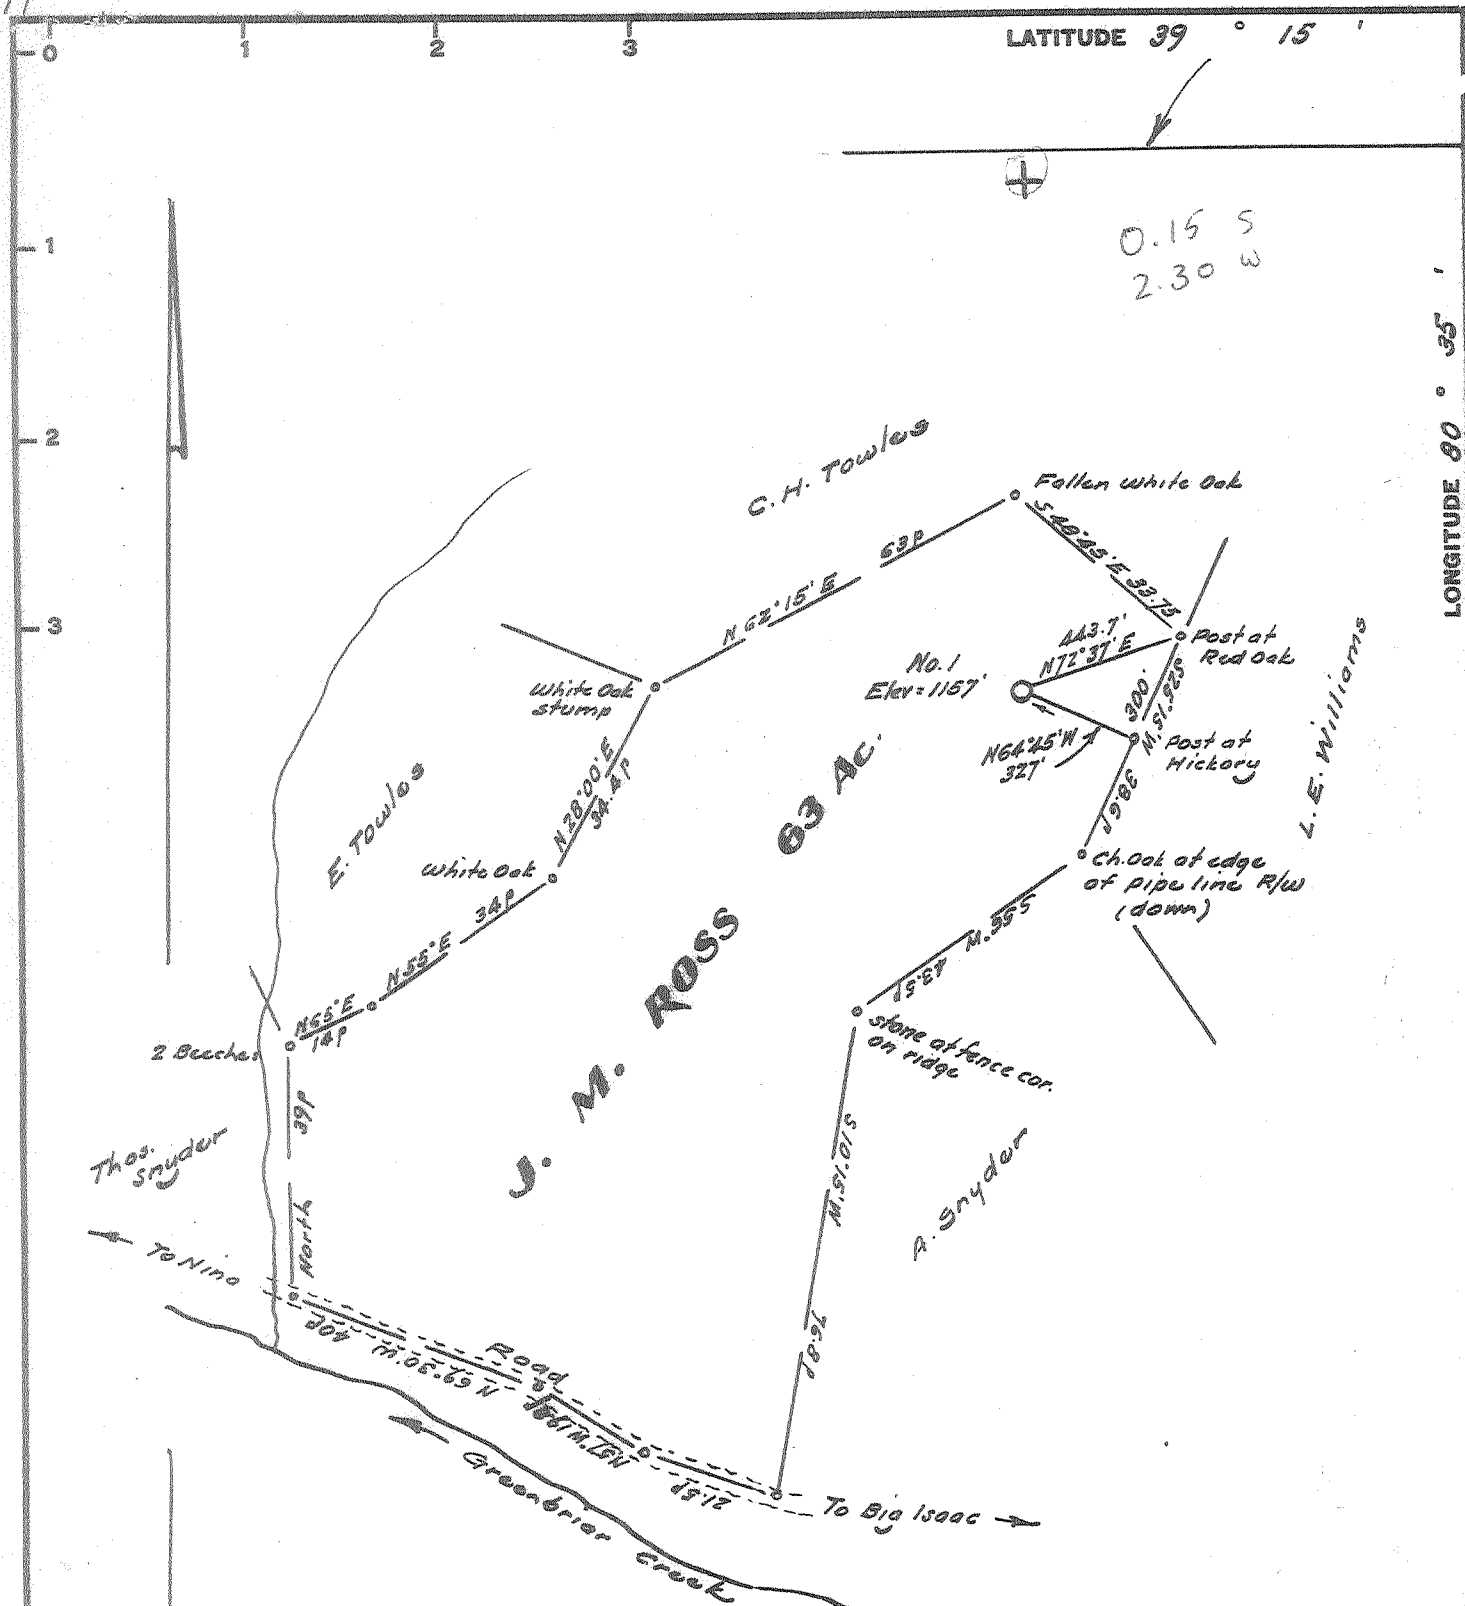

I, the undersigned, hereby certify that this map is correct to the best of my knowledge and belief and shows all of the information required by paragraph 5 of the rules and regulations of the oil and gas section of the mining laws of West Virginia.

W. F. R. No. 122
 W. F. R. No. 122

New Location
 Drill Deeper
 Abandonment

Elev. ref: - Elev. at mo. of Buckeye = 890'

Error in Closure less than 1 in 200'

Company JAMES F. SCOTT
 Address 124 Valley St., Salem, West Va.
 Farm J. M. Ross
 Tract Acres 63 Lease No.
 Well (Farm) No. One Serial No.
 Elevation (Spirit Level) 1157
 Quadrangle Vadis - NC
 County Doddridge District Greenbrier
 Engineer *W. F. R.*
 Engineer's Registration No. 1227
 File No. Drawing No.
 Date June 3, 1966 Scale 1" = 320' = 495'

STATE OF WEST VIRGINIA
 DEPARTMENT OF MINES
 OIL AND GAS DIVISION
 CHARLESTON

WELL LOCATION MAP
 FILE NO. DOR - 1395

+ Denotes location of well on United States Topographic Maps, scale 1 to 62,500, latitude and longitude lines being represented by border lines as shown.

- Denotes one inch spaces on border line of original tracing.



STATE OF WEST VIRGINIA
DEPARTMENT OF MINES
OIL AND GAS DIVISION 3

Quadrangle Vadie

Permit No. DOD-1385

WELL RECORD

Oil or Gas Well Gas

Company James F. Scott
Address 124 Valley Street, Salem, West Va.
Farm J. M. Ross Acres 63
Location (waters) Greenbrier
Well No. 1 Elev. 1157
District Greenbrier County Doddridge
The surface of tract is owned in fee by Kenneth Chamley
Address Salem, West Va.
Mineral rights are owned by Kenneth Chamley Et. Al
Address Salem, West Va.

Casing and Tubing	Used in Drilling	Left in Well	Packers
Size			
16	60	60	Kind of Packe
13			
10	301		Size of
8 1/2	1617	1617	
6 3/4			Depth set
LINE 4 1/2	2280	2280	
3			Perf. top <u>2200</u>
2			Perf. bottom <u>2207</u>
Lineys Used			Perf. top <u>2242</u>
			Perf. bottom <u>2247</u>


Drilling commenced June 11, 1966
Drilling completed August 17, 1966
Date Shot From To
With
Open Flow /10ths Water in Inch
/10ths Merc. in Inch
Volume SNOW Cu. Ft.
Rock Pressure lbs. hrs.
Oil bbls., 1st 24 hrs.
WELL ACIDIZED
WELL FRACTURED YES

CASING CEMENTED 4 1/2" SIZE 2280 No. 8/19/66 Date

COAL WAS ENCOUNTERED AT 785 FEET INCHES
FEET INCHES FEET INCHES
FEET INCHES FEET INCHES

RESULT AFTER TREATMENT 15mcf
ROCK PRESSURE AFTER TREATMENT 380
Fresh Water Feet Salt Water 1570 - 1580 Feet

Formation	Color	Hard or Soft	Top	Bottom	Oil, Gas or Water	Depth	Remarks
Soil				50			
Slate & Shells			50	70			
Sand			70	80			
Slate			80	105			
Red Rock			105	153			
Slate			155	190			
Red Rock			190	250			
Slate			250	262			
Sand			262	295			
Slate			295	340			
Sand & shells			340	390			
Red Rock			390	395			
Slate & Shells			395	409			
Red Rock			409	421			
Lime			431	442			
Slate & Shells			442	450			
Red Rock			450	485			
Lime			485	490			
Sand			490	499			
Slate			499	541			
Sand			541	613			
Slate			613	718			
Red Rock			718	731			
Sand			731	760			
Slate & Shells			760	784			
Sand			784	786			
Coal			766	772			
Gritty lime			772	795			
Sand			795	825			

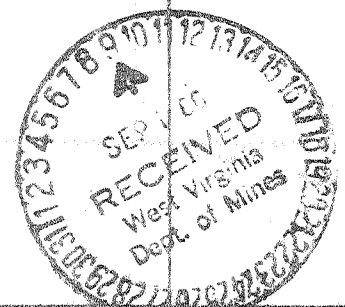

Formation	Color	Hard or Soft	Top \bar{z}	Bottom	Oil, Gas or Water	Depth Found	Remarks
Lime			825	887			
Sand			887	914			
Slate			1098	1151			
Red Rock			1151	1187			
Lime			1187	1245			
Slate & shells			1245	1311			
Lime			1311	1395			
Slate & Shells			1395	1487			
Slate			1487	1555			
Sand			1555	1613			
Lime			1613	1718			
Slate			1718	1754			
Sand			1754	1816			
Lime			1889	1889			
Sand			1889	1900			
Sand			1900	1955			
Slate			1955	1990			
Red Rock			1990 c	2035			
Sand			2035	2060			
Sand			2060	2080			
Lime			2080	2100			
Pencil cave			2117	2117			
Big Lime			2117	2195			
Injun			2195	2282			

Date September 7, 1946
 APPROVED Lewis F. Post Owner
 By _____ (Title)