


LATITUDE 29° 15'

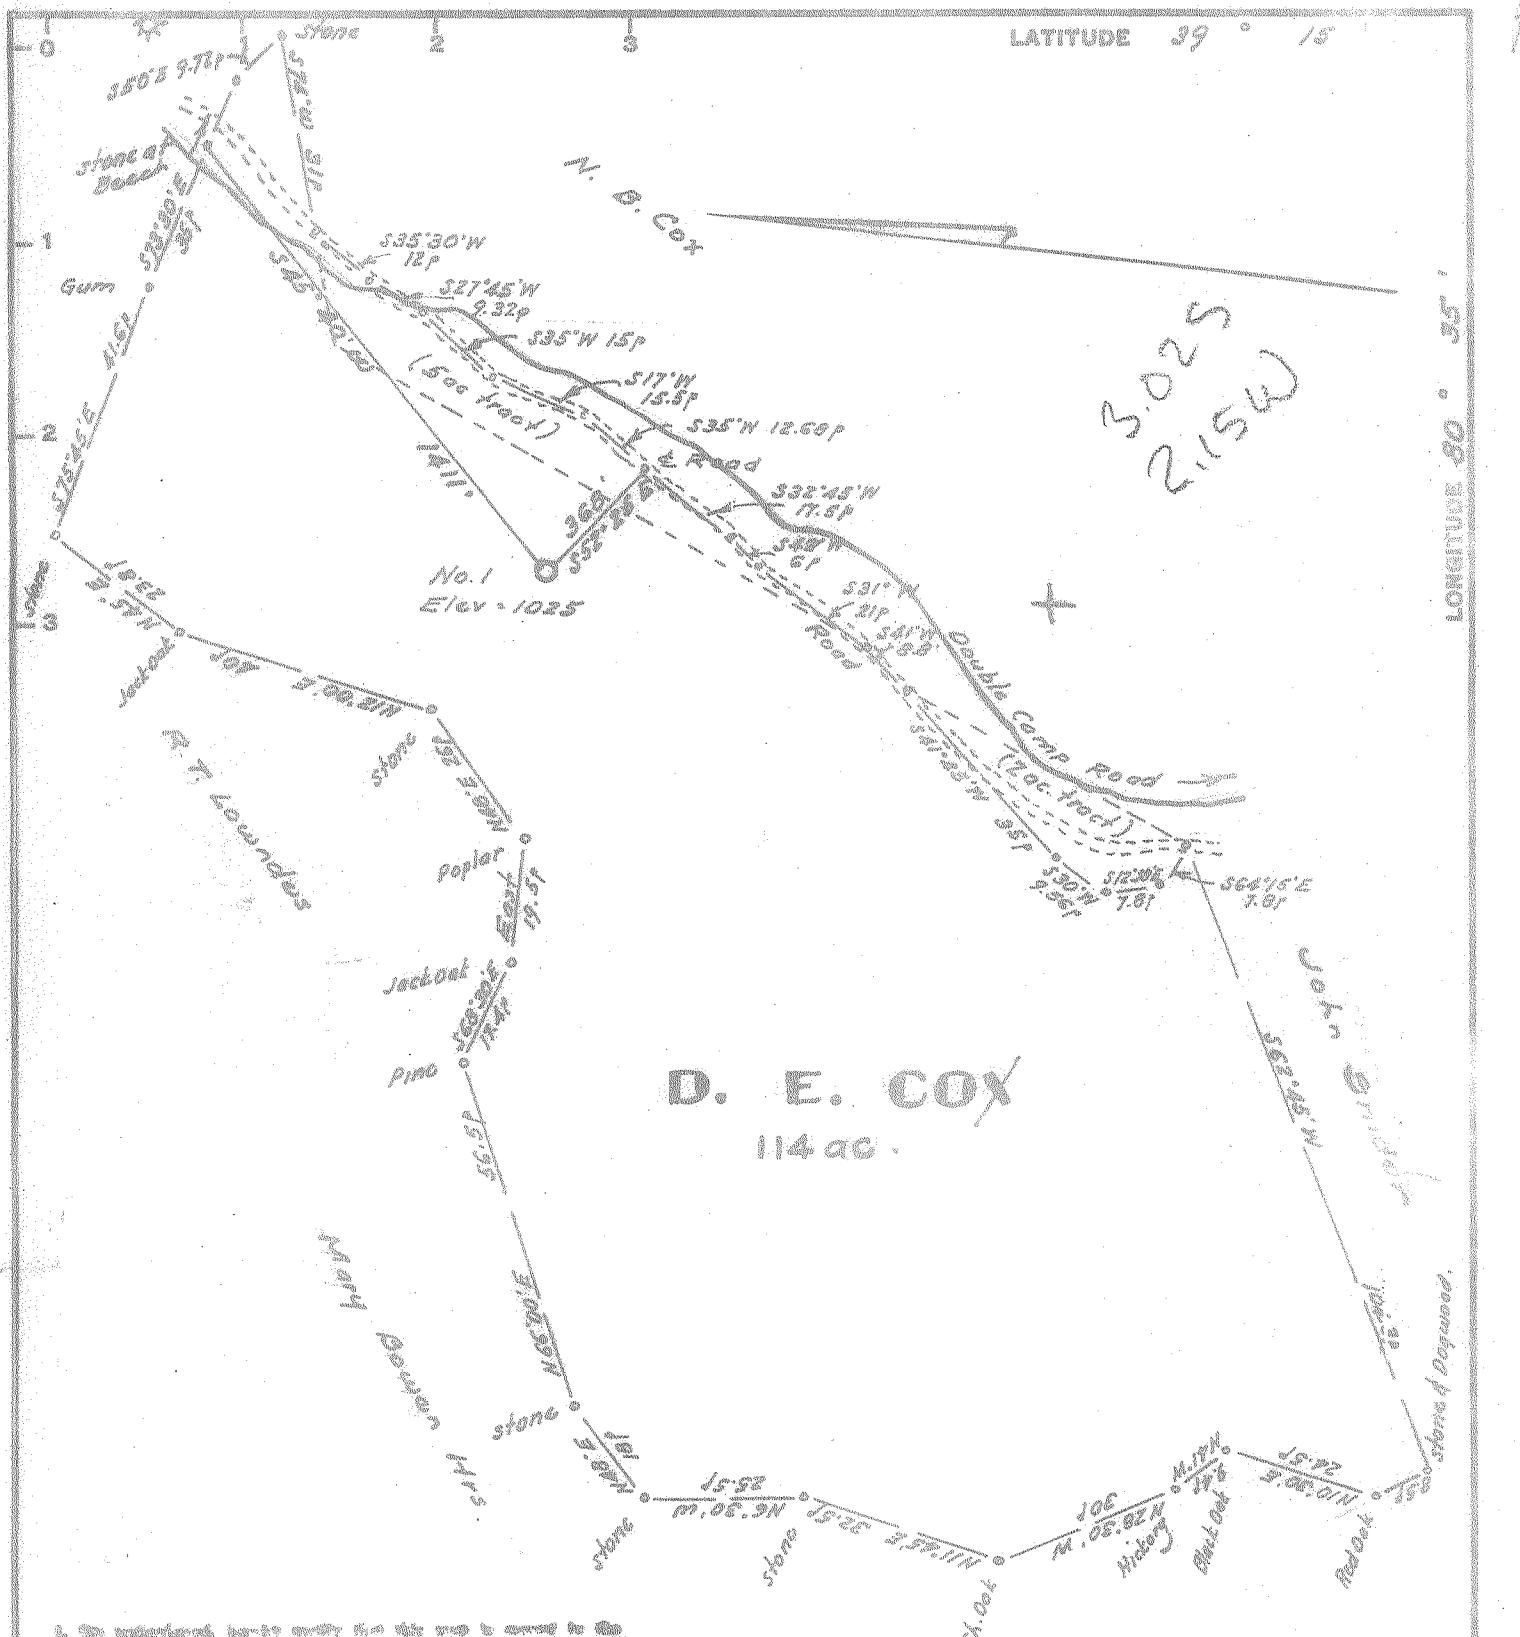

b. The undersigned hereby certifies that she/he is aware of the laws of my knowledge and belief and shows all of the information contained by paragraph 6 of the rules and regulations of the oil and gas section of the mining laws of West Virginia.

W. H. Smith

New Location...
Drill Deeper
Abandonment

Elev. ref.: B.M. on Bridge 1 mi. west
= 685

Please see Closure - Location 1 on Book

Company JAMES E. SCOTT

Address — 124 Yellow St., Salem, W. Va.

Farm: D.E. Gay

Tract _____ Acre(s) 114 _____ Lease No. _____

Well (Farm) No. One \$

Elevation (Sprint Level) — 102.5

Quadrangle - Yadkin - NC

County - Deadridge - District -

Engineer Wm. H. D.

Engineer's Registration No. 1227

**STATE OF WEST VIRGINIA
DEPARTMENT OF MINES
OIL AND GAS DIVISION
CHARLESTON**

WELL LOCATION MAP

FILE NO. BOP-1400

* Denotes location of well on United States Topographic Maps, scale 1 to 62,500, latitude and longitude lines being represented by border lines as shown.

- Denotes one inch spaces on border line of original tracing.