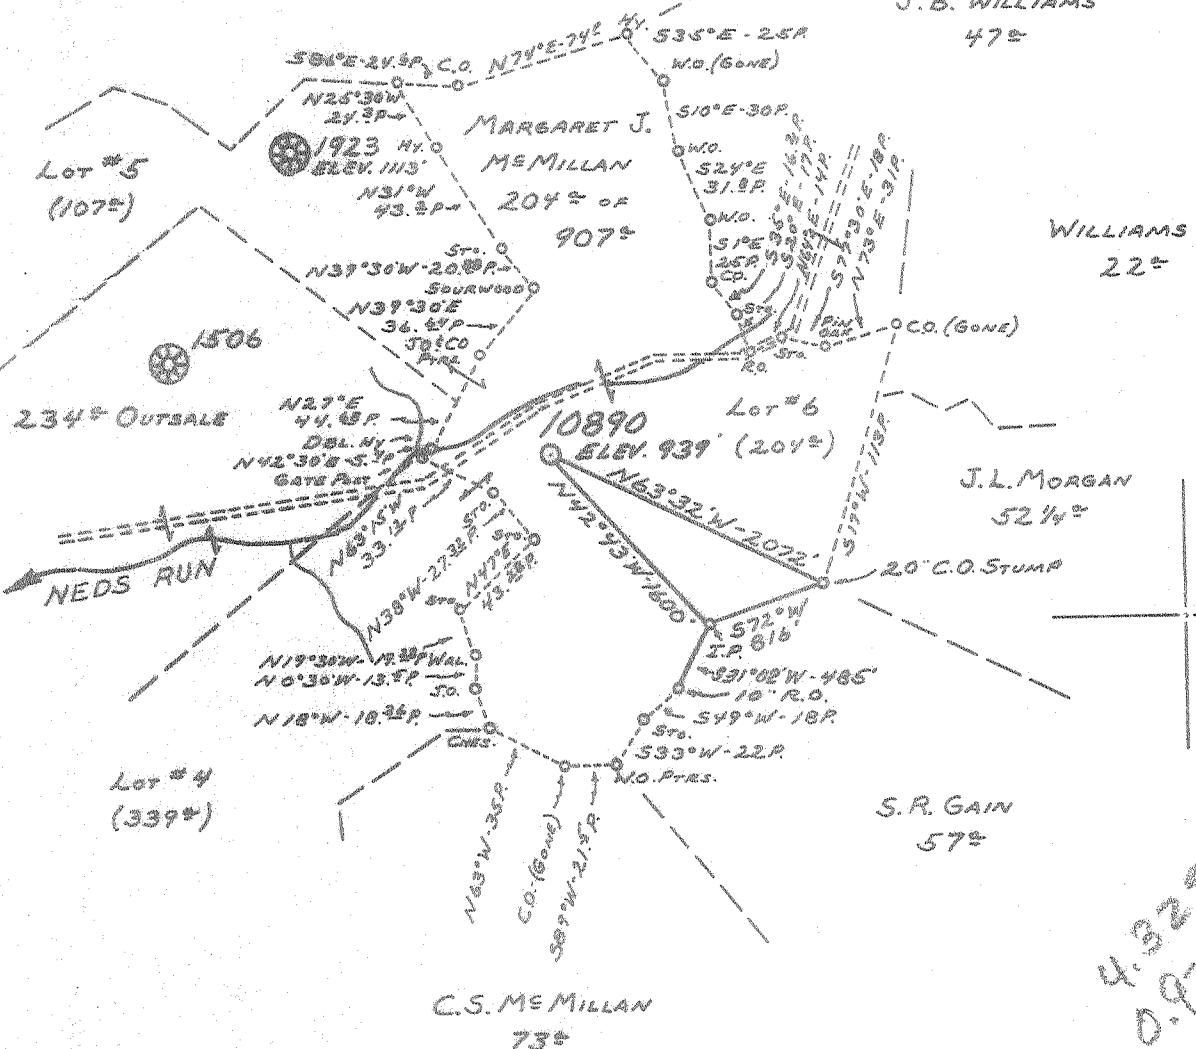


LATITUDE $39^{\circ} 25'$ J.M.CARR
3512J.B. WILLIAMS
472

Minimum Error of Closure 1' IN 200'

Source of Elevation ROAD FORK (15' CENTERPOINT TOPO MAP) ELEV. 905'

"I, the undersigned, hereby certify that this map is correct to the best of my knowledge and belief and shows all the information required by paragraph 6 of the rules and regulations of the oil and gas section of the mining laws of West Virginia."

New Location Drill Deeper Abandonment

MAP SHEET 53 S-7, W-4

F.B. 1421 Pg. 33-34

Company	CONSOLIDATED GAS SUPPLY CORP.	
Address	CLARKSBURG, W. Va.	
Farm	MARGARET J. Mc MILLAN	
Tract	Acres $\frac{204}{70.8}$	Lease No. 17299
Well (Farm) No.	Serial No. 10890	
Elevation (Spirit Level)	939'	
Quadrangle	CENTERPOINT WC	
County	DODDREIDGE	District GRANT
Engineer	Jackson M. Jones	
Engineer's Registration No.	2397	
File No.	Drawing No.	
Date	2-3-67 Scale 1" = 1320'	

STATE OF WEST VIRGINIA
DEPARTMENT OF MINES
OIL AND GAS DIVISION
CHARLESTON

WELL LOCATION MAP

FILE NO. DOD-1449

+ Denotes location of well on United States Topographic Maps, scale 1 to 62,500, latitude and longitude lines being represented by border lines as shown.

-- Denotes one inch spaces on border line of original tracing.