


LATITUDE 39° 15'

LONGITUDE 80° 50'

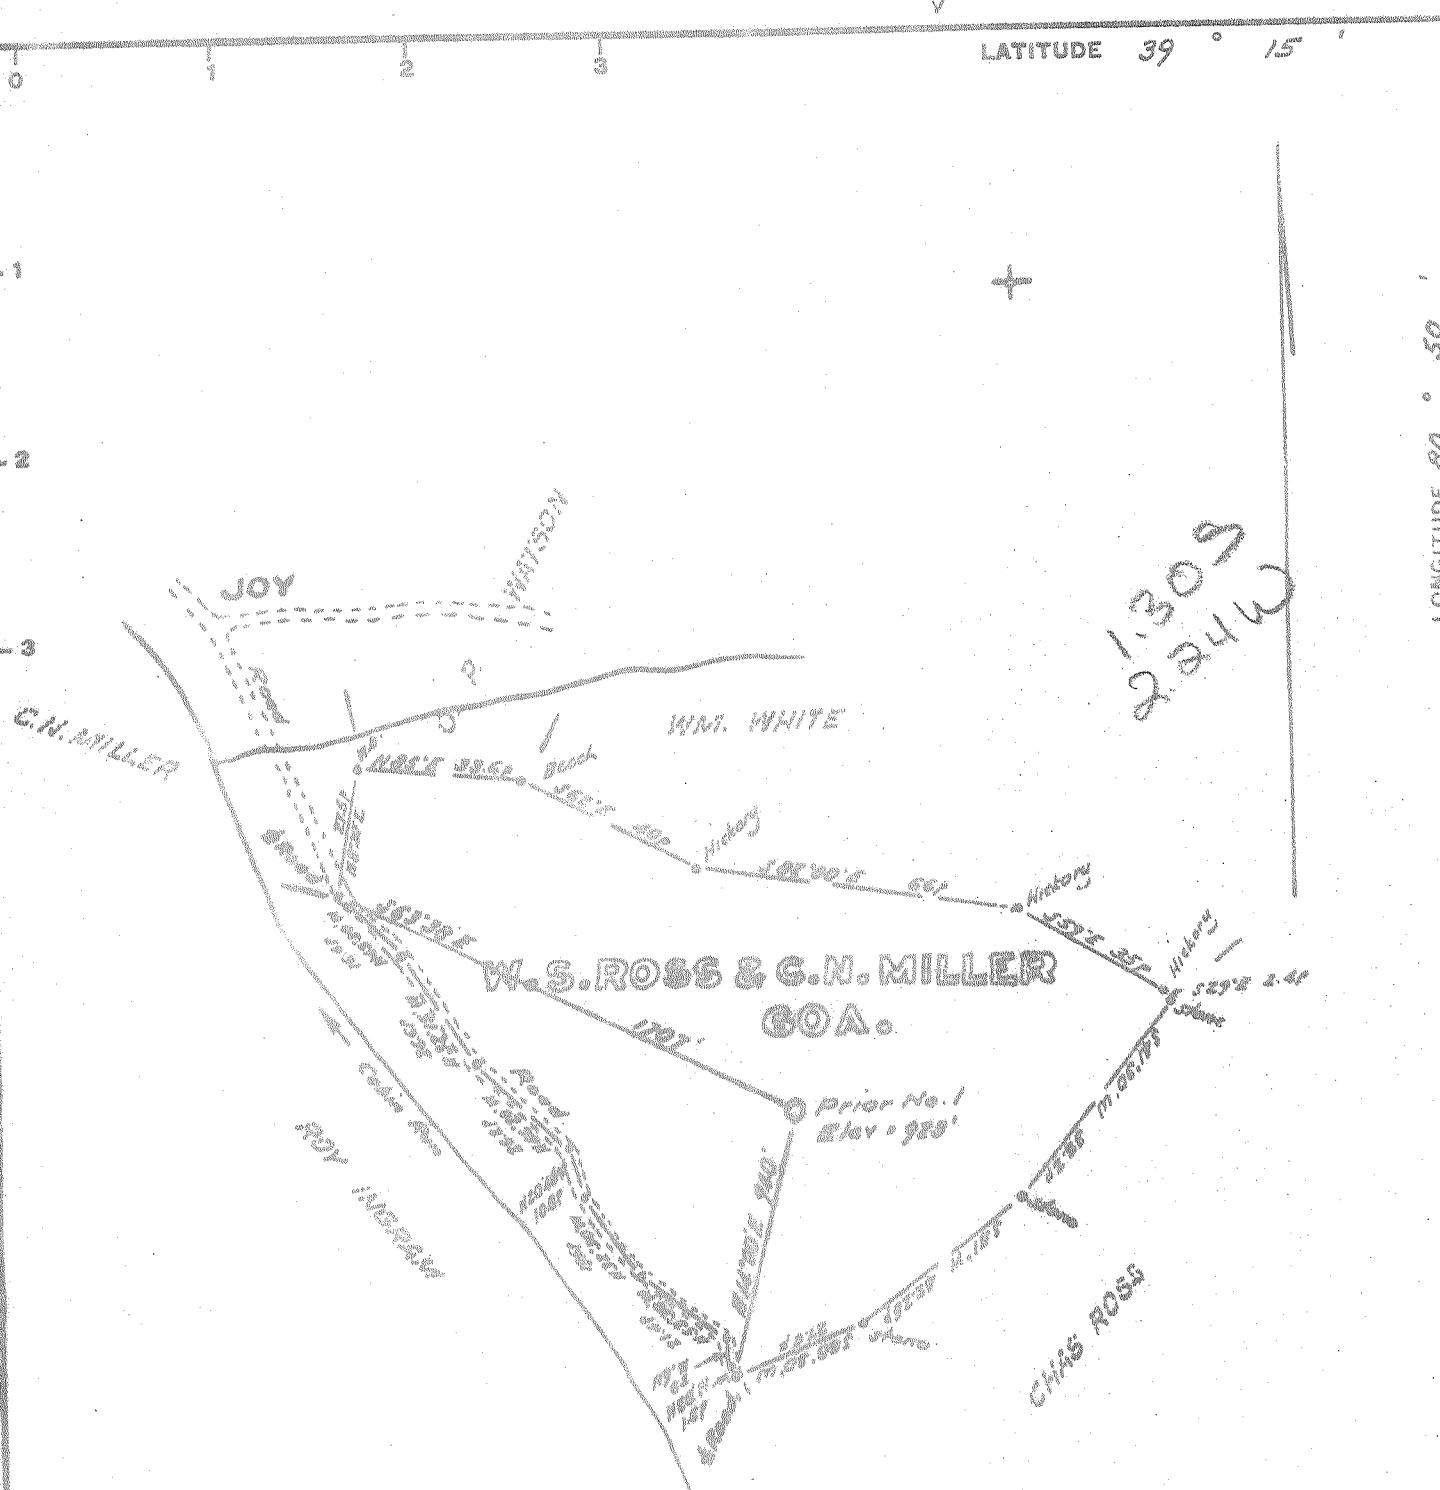

Minimum Error of Closure Lin 200

Source of Elevation B.M. at Oxford = 915

- Fracture
 New Location
 Drill Bumper
 Abandonment

I, the undersigned, hereby certify that this map is correct to the best of my knowledge and belief and shows all the information required by paragraph 6 of the rules and regulations of the oil and gas section of the mining laws of West Virginia.

Signed: W.H. Ross Jr.
 Map No. _____
 Square: N S E W

Company	PRIOR OIL COMPANY		
Address	224 Washington Blvd., Belaire, Ohio.		
Farm	W. S. Ross & C. N. Miller		
Tract	Acre	Acres	Lease No.
Well (Farm) No.	L	Serial No.	
Elevation (Spirit Level)	920'		
Quadrangle	Hollinsack NC		
County	Randridge District Central		
Engineer	<u>W.H. Ross Jr.</u>		
Engineer's Registration No.	1227		
File No.	Drawing No.		
Date	July 4, 1967 Scale 1" = 400 ft. S.G.D.		

STATE OF WEST VIRGINIA
 DEPARTMENT OF MINES
 OIL AND GAS DIVISION
 CHARLESTON

WELL LOCATION MAP

FILE NO. DOD - 1469

+ Denotes location of well on United States Topographic Maps, scale 1 to 62,500, latitude and longitude lines being represented by border lines as shown.

- Denotes one inch spaces on border line of original tracing.