

- Fracture.....
- Redrill.....
- New Location.
- Drill Deeper.....
- Abandonment.....

Source of Elevation WELL NO 4596, ELV. 973'

I, the undersigned, hereby certify that this map is correct to the best of my knowledge and belief and shows all the information required by paragraph 6 of the rules and regulations of the oil and gas section of the mining laws of West Virginia.

Minimum accuracy, one part in 200

Co Bet-Ro Inc.  
 HC 77, Box 7-T  
 Ac Glenville, Wva. 26351  
 Surface Owner: Mansfield Leeson

Fa

Tract \_\_\_\_\_ Acres 190 Lease No. \_\_\_\_\_

Well (Farm) No. 3 Serial No. 2

Elevation (Spirit Level) 1068'

Quadrangle HOLBROOK 15 Oxford 75

County DODDRIDGE District SOUTHWEST

Engineer James J. Jeffers

Engineer's Registration No. 1064

File No. 214/146 Drawing No. \_\_\_\_\_

Date 10-17-68 Scale 1" = 500'


WEST VIRGINIA  
 DIVISION OF ENVIRONMENTAL PROTECTION  
 OFFICE OF OIL AND GAS  
 #10 McJUNKIN ROAD  
 NITRO, WEST VIRGINIA 25143-2506

**WELL LOCATION MAP**

Well No. 47-017-01534-P

Well drill in 1968 TO 2142'  
Production from Big River?  
injin. Squaw.

JUL 25 1997

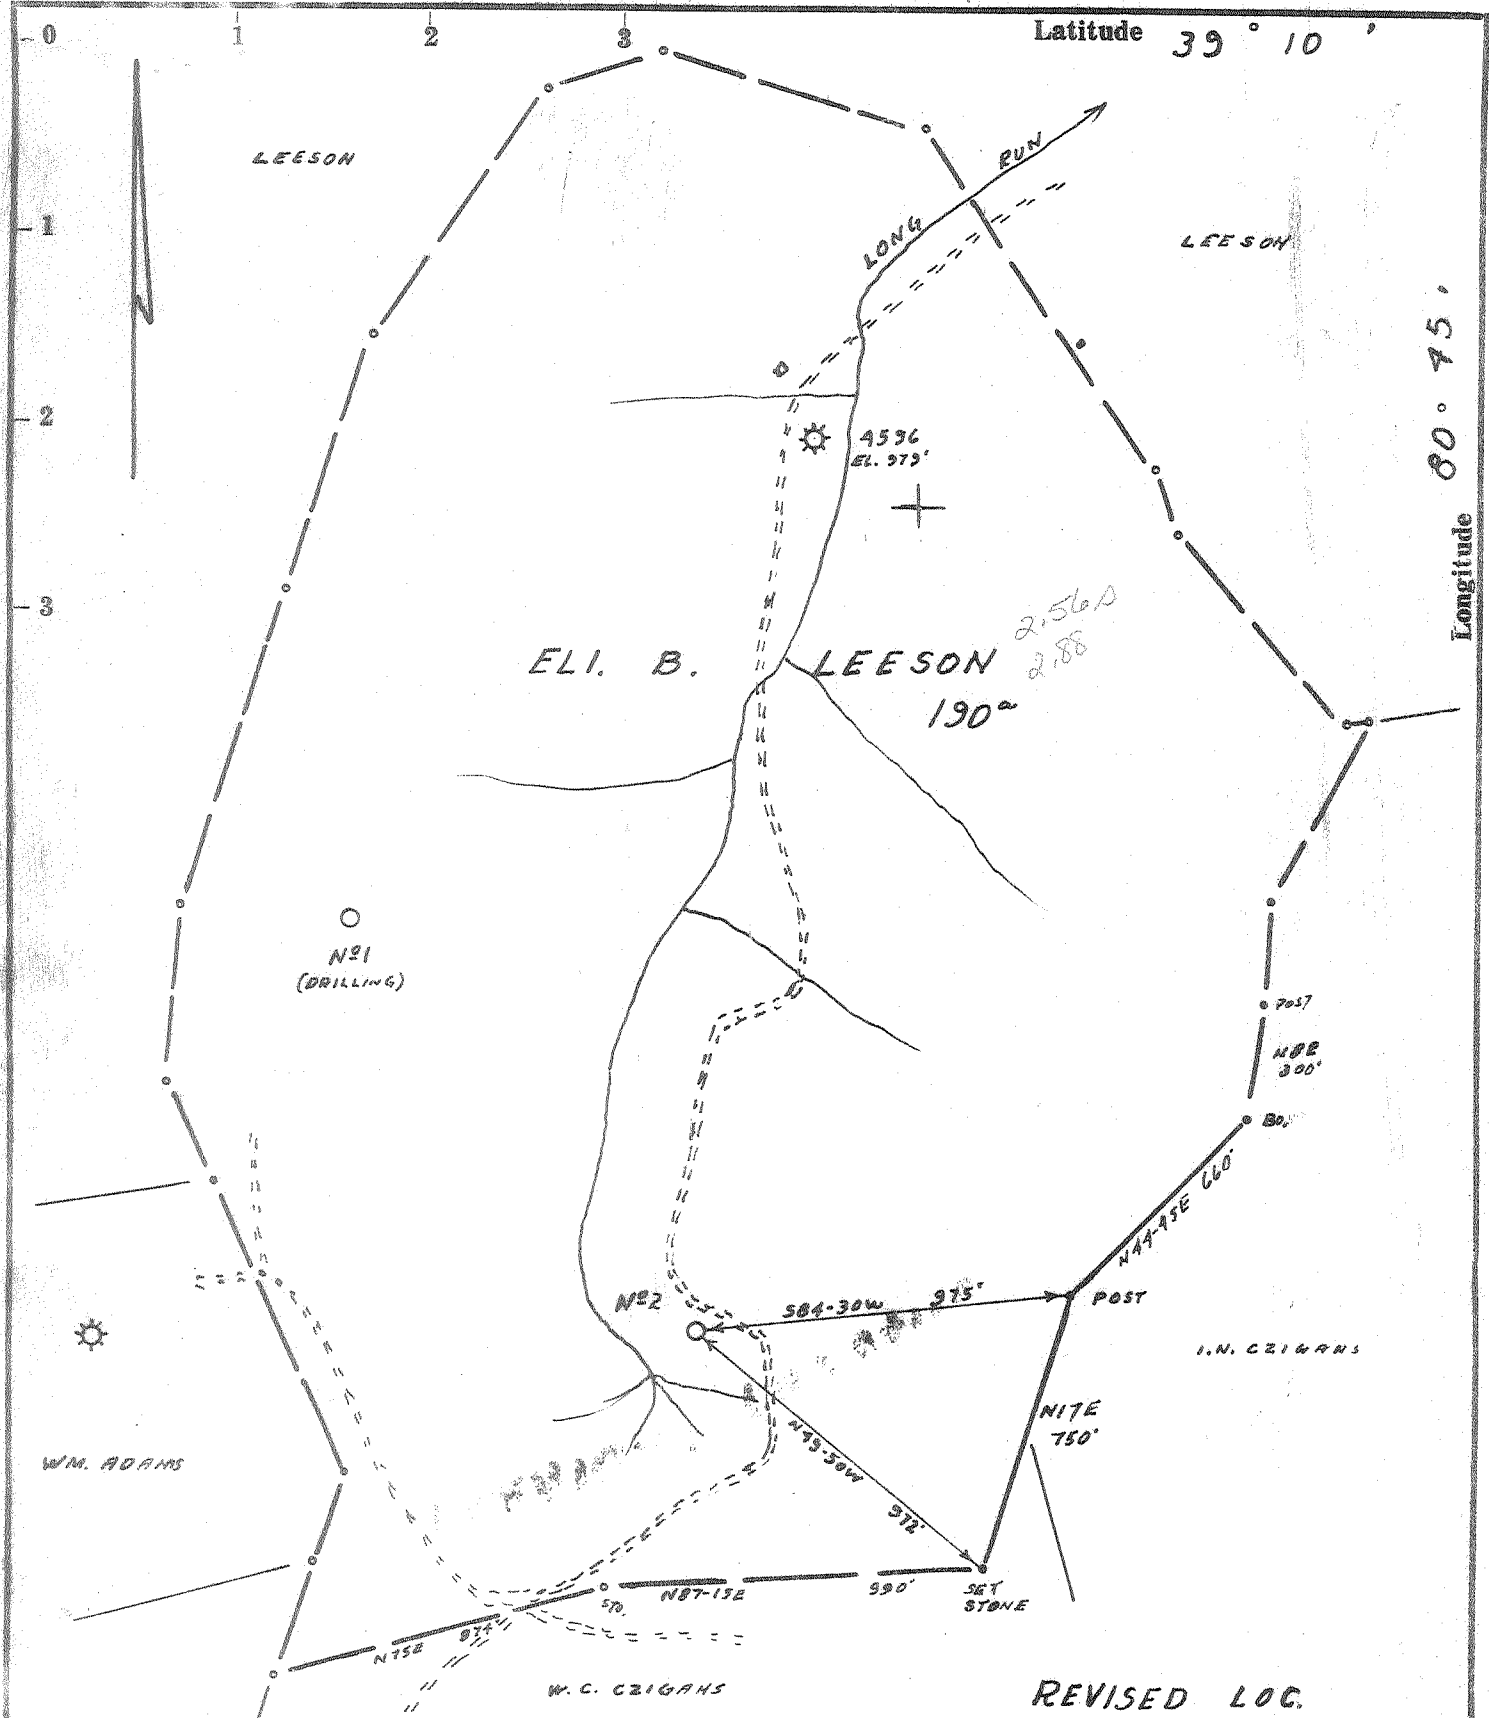

- Fracture.....
- Redrill.....
- New Location.
- Drill Deeper.....
- Abandonment.....

Source of Elevation WELL NO 4596, ELV. 975'

I, the undersigned, hereby certify that this map is correct to the best of my knowledge and belief and shows all the information required by paragraph 6 of the rules and regulations of the oil and gas section of the mining laws of West Virginia.

Minimum accuracy, one part in 200

Company	WILLARD E. FERRELL	
Address	PHILADELPHIA, PA. Box 5056	
Farm	ELI B. LEESON	
Tract	Acres 190	Lease No.
Well (Farm) No.	3	Serial No. 2
Elevation (Spirit Level)	1068'	
Quadrangle	HOLBROOK NE 42 EC	
County	DODDRIDGE District SOUTHWEST	
Engineer	James J. Deffen	
Engineer's Registration No.	1084	
File No.	214/146	Drawing No.
Date	10-17-68	Scale 1" = 500'

STATE OF WEST VIRGINIA  
DEPARTMENT OF MINES  
OIL AND GAS DIVISION  
CHARLESTON

WELL LOCATION MAP  
FILE NO. Dod-1534-Rev

- + Denotes location of well on United States Topographic Maps, scale 1 to 62,500, latitude and longitude lines being represented by border lines as shown.
- Denotes one inch spaces on border line of original tracing.



STATE OF WEST VIRGINIA  
DEPARTMENT OF MINES  
OIL AND GAS DIVISION /

Rotary   
Spudder   
Cable Tools   
Storage

Quadrangle.....

WELL RECORD

Permit No. DOD 1534

Oil or Gas Well Gas  
(KIND)

Company <u>Tamiami Development Corp. 2 Willard E. Forrester and Agent</u>	Used in Drilling	Left in Well	Packers
Address <u>P.O. Box 5056, Philadelphia, Pa. 19111</u>			
Farm <u>Eli B. Leeson</u> Acres <u>190</u>	Size		Kind of Packer
Location (waters)	16. <u>18</u>	<u>20</u>	
Well No. <u>2</u> Elev. <u>1248</u>	13. <u>290</u>	<u>290</u>	Size of
District <u>Southwest</u> County <u>Doddridge</u>	10. <u>1030</u>		Depth set
The surface of tract is owned in fee by <u>Eli B. Leeson, heirs</u>	8 1/4		
Address <u>West Union</u>	6%		
Mineral rights are owned by <u>Eli B. Leeson, heirs</u>	5 3/16		
<u>G.R. Spencer, Atty. in Fact for Heirs</u>	4 1/2	<u>2140</u>	<u>2140</u>
Address <u>West Union, W. Va.</u>	3		Perf. top
Drilling commenced <u>11/13/68</u>	2		Perf. bottom
Drilling completed <u>12/8/68</u>	Liners Used		Perf. top
Date Shot From To			Perf. bottom
With	Attach copy of cementing record.		
Open Flow <u>9/10ths</u> Water in <u>1</u> Inch	CASING CEMENTED <u>4 1/2</u> SIZE <u>200</u> No. Ft. <u>12/13/68</u> Date		
<u>/10ths</u> Merc. in <u>    </u> Inch	Amount of cement used (bags) <u>65</u>		
Volume <u>35M</u> Cu. Ft.	Name of Service Co. <u>Lawson</u>		
Rock Pressure <u>Not taken</u> lbs. hrs.	COAL WAS ENCOUNTERED AT FEET INCHES		
Oil <u>    </u> bbls., 1st 24 hrs.	FEET INCHES FEET INCHES		
WELL ACIDIZED (DETAILS)	FEET INCHES FEET INCHES		
WELL FRACTURED (DETAILS) <u>Using 800 bls fluid-River-frac- 500 gal acid-40M lbs sand</u>	Took the fracture very nicely.		
RESULT AFTER TREATMENT (Initial open Flow or bbls.) <u>1 1/2 million cuft.</u>	<u>1,500,000</u> <u>1,500M</u>		
ROCK PRESSURE AFTER TREATMENT <u>700</u>	HOURS <u>24</u>		
Fresh Water <u>    </u> Feet	Salt Water <u>    </u> Feet		
Producing Sand <u>Big Injun</u>	Depth <u>2093 - 2126</u>		

Formation	Color	Hard or Soft	Top	Bottom	Oil, Gas or Water	Depth	Remarks
Clay			0	25			
Red Rock			25	120			
Slate			120	228			
Red Rock			228	280			
Slate			280	295			
Red Rock			295	350			
Sand			350	375			
Red Rock			375	425			
Slate & Shells			425	500			
Red Rock			500	670			
Slate & Shells			670	760			
Red Rock			760	820			
Slate & Shells			820	840			
Sand			840	850			
Red Rock & Shells			850	900			
Slate & Shells			900	950			
Red Rock			950	965			
Sand			965	1008			
Lime			1008	1025			
Slate & Shells			1025	1150			
Red Rock			1150	1358			
Sand			1358	1432			
Lime			1432	1450			
Sand			1450	1505			
Black Slate			1505	1520			
Lime G			1520	1673			
Sand			1673	1705			
Gritty Lime			1705	1816			
Sand			1816	1841			
(over)							



Formation	Color	Hard or Soft	Top	Bottom	Oil, Gas or Water	Flow Found	Remarks
B Slate			1841	1835			
Red Rock			1885	1942			
Lime			1942	1971			
Late shells			1971	1988			
Big Lime			1988	2043			
and			2043	2068			
Lime			2068	2093			
and	Big Fajon		2093	2126			
Slate & shells			2126				
Total Depth				2142			

Date Jan. 15, 1969

APPROVED Richard E. Farnsworth, Owner

By \_\_\_\_\_ (Title)

RECEIVED  
WV Division of  
Environmental Protection

RR-38  
1-Jul-97

API # 47- 17-01534-P

STATE OF WEST VIRGINIA  
DIVISION OF ENVIRONMENTAL PROTECTION  
SECTION OF OIL AND GAS

Permitting  
Office of Oil & Gas

AFFIDAVIT OF PLUGGING AND FILLING WELL

AFFIDAVIT SHOULD BE IN TRIPLICATE, one copy mailed to the Division, one copy to be retained by the Well Operator and the third copy (and extra copies if required) should be mailed to each coal operator at their respective addresses.

Farm name: LEESON, MANSFIELD Operator Well No.:2

LOCATION: Elevation: 1,248.00 Quadrangle: OXFORD  
District: SOUTHWEST County: DODDRIDGE  
Latitude: 13680 Feet South of 39 Deg. 10 Min. 0 Sec.  
Longitude 0 Feet West of 80 Deg. 47 Min. 30 Sec.

Well Type: OIL \_\_\_\_\_ GAS XX

Company: Bet-Ro Inc.  
Rt. 77, Box 7-D  
Glenville, WV. 26351

Coal Operator None  
or Owner \_\_\_\_\_

Agent: William Stalnaker

Coal Operator None  
or Owner \_\_\_\_\_

Permit Issued: 07/25/97

AFFIDAVIT

STATE OF WEST VIRGINIA,  
County of Gilmer

ss:

Permitting  
Office of Oil & Gas

R.L.Roberts and Phil Pulliam being first duly sworn according to law depose and say that they are experienced in the work of plugging and filling oil and gas wells and were employed by the above named well operator, and participated in the work of plugging and filling the above well, and Mike Underwood & Phillip Tracy Oil and Gas Inspector representing the Director, say that said work was commenced on the 15th day of Aug., 1997, and that the well was plugged and filled in the following manner:


TYPE	FROM	TO	PIPE REMOVED	LEFT
Hole gelled to surface				
Cement	1996	1680	4 1/2" 760'	1236'
Cement	700	600	10" 145'	?
Cement	100	-0-	18" 3'	?
Remarks:	The well record was wrong for this well T.D. 1996			
	Cut 4 1/2" at 760 had to pull to 700' to get out of cavings.			
	Cement plug were approved by Phil Tracy			

Description of monument: 7" marker 30" above ground with API No. 47-017-1534-P and that the work of plugging and filling said well was completed on the 21st day of Aug., 1997.

And further deponents saith not.

Sworn and subscribe before me this 22 day of Aug., 1997  
My commission expires: March 29, 1999

R.L. Roberts  
Phil Pulliam  
Sandra Drake  
Notary Public

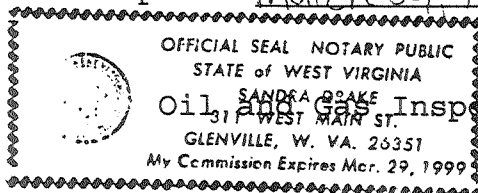

Oil and Gas Inspector: Mike Underwood and Phillip Tracy

SEP 5 1997