

WW-7
8-30-06



West Virginia Department of Environmental Protection
Office of Oil and Gas
WELL LOCATION FORM: GPS

API: 47-017-01678 WELL NO.: WV 453131 (Haddox W-11488)

FARM NAME: J. L. Haddox

RESPONSIBLE PARTY NAME: EQT Production Company

COUNTY: Doddridge DISTRICT: McClellan

QUADRANGLE: Folsom 7.5'

SURFACE OWNER: Lorie J. and Tracie P. Leonard

ROYALTY OWNER: Ercel Ashcraft, et al.

UTM GPS NORTHING: 4364190

UTM GPS EASTING: 535813 GPS ELEVATION: 376 m (1234 ft)

The Responsible Party named above has chosen to submit GPS coordinates in lieu of preparing a new well location plat for a plugging permit or assigned API number on the above well. The Office of Oil and Gas will not accept GPS coordinates that do not meet the following requirements:

- Datum: NAD 1983, Zone: 17 North, Coordinate Units: meters, Altitude: height above mean sea level (MSL) – meters.
- Accuracy to Datum – 3.05 meters
- Data Collection Method:
Survey grade GPS : Post Processed Differential
Real-Time Differential
Mapping Grade GPS X: Post Processed Differential X
Real-Time Differential
- Letter size copy of the topography map showing the well location.**

I the undersigned, hereby certify this data is correct to the best of my knowledge and belief and shows all the information required by law and the regulations issued and prescribed by the Office of Oil and Gas.


Signature

PS# 2180
Title

3/1/16
Date

Received
Office of Oil & Gas
MAR 14 2016

04/01/2016

1701678P

Topo Quad: Folsom 7.5'

Scale: 1" = 2000'

County: Doddridge


Date: February 18, 2016

District: McClellan

Project No: 67-30-00-08

47-017-01678 WV 453131 (Haddox W-11488)

Topo

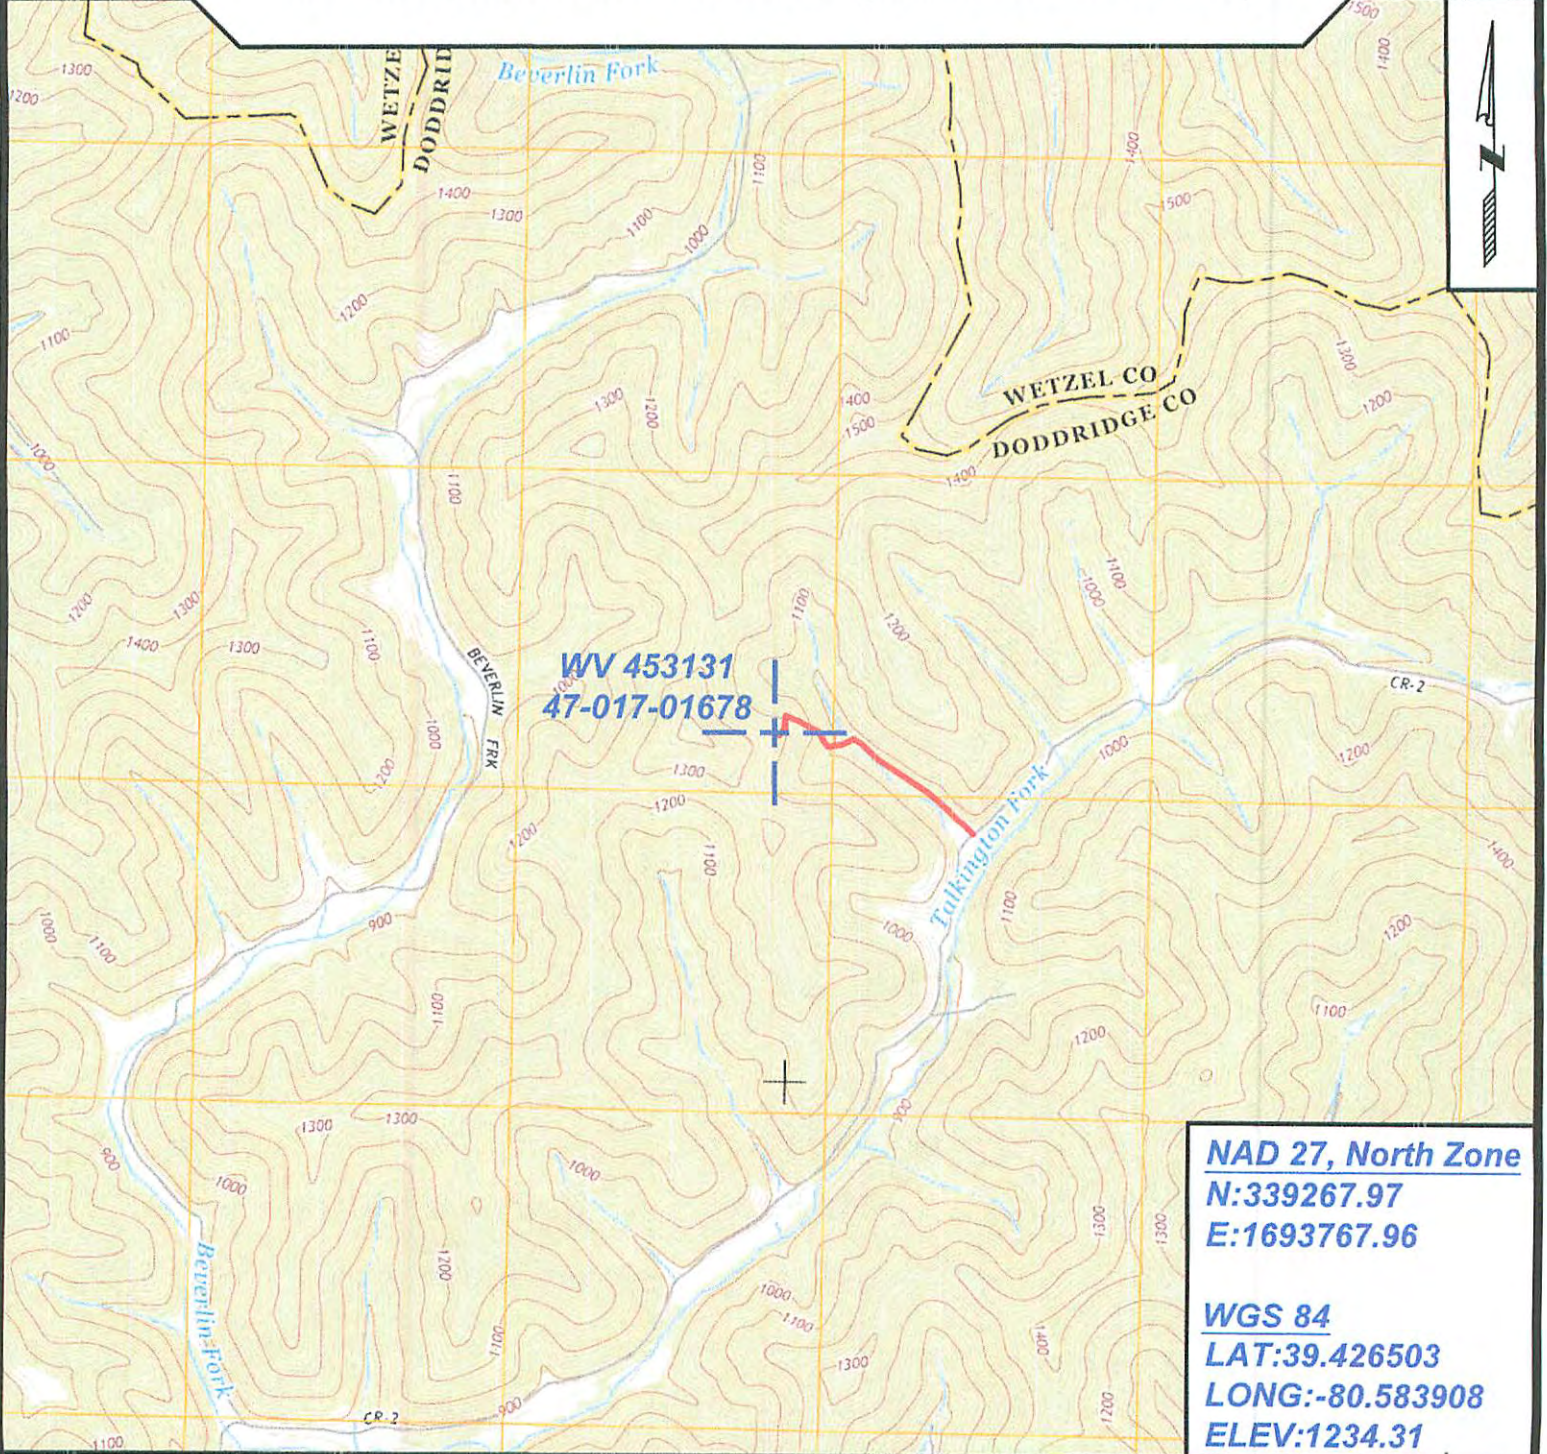

NAD 27, North Zone
N:339267.97
E:1693767.96

WGS 84
LAT:39.426503
LONG:-80.583908
ELEV:1234.31



SURVEYING AND MAPPING SERVICES PERFORMED BY:
ALLEGHENY SURVEYS, INC.
 1-800-482-8606
 237 Birch River Road
 Birch River, WV 26610
 PH: (304) 649-8606
 FAX: (304) 649-8608

PREPARED FOR:
EQT Production Company
 Received
 Office of Oil & Gas
 P.O. Box 280
 Bridgeport, WV 26330
 MAR 14 2016
04/01/2016