

LATITUDE 39° 22' 30"

09-53-08 LONGITUDE



7'5 OGIS topo location

7.5' loc	<u>1.685</u>	15' loc	<u>4565</u>
	<u>0.25W</u>	(calc.)	<u>0.25W</u>

Company \_\_\_\_\_

Farm \_\_\_\_\_

Well 1080' - 75' topo k/a 3/5 h3  
centerpoint C

Quad SALEM 7 1/2'

County DOORIDGE

District MCCLELLAN

WELL LOCATION MAP

File No. 017-1911

LOCATION FOR WELL No. 840


Salem DISTRICT.

On W. J. S. Hutton Farm, on waters of Robinson Fork

McClellan District, Doddridge County, West Virginia.

Lease No. 3753 Acres Range: N. S. 7 E. 2 W.

Scale: 1" = 80 ft. Made Oct. 26 1908

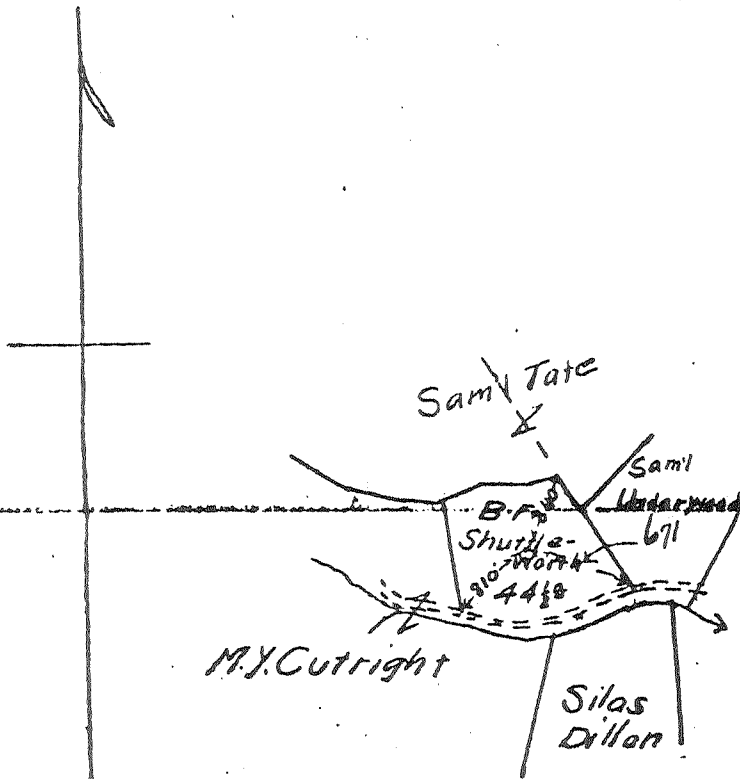

Note: This farm is squeezed on the map. Measurements are correct.

ENTERED	
WELL BOOK	_____
LEASE RECORD	_____
LEASE DOCKET	_____
WALL MAP	_____
WORKING MAP	_____
LOCATION BOOK	_____

ENTERED  
LINE MAP  
BY \_\_\_\_\_

LOCATION MADE	10-26-1908
BY	Richard Owen
As per plat. Except as noted	
On Field Map	19
Returned to Pittsburg	19

017-1911  
APT #

ENTERED	
WELL BOOK	_____
LEASE RECORD	_____
LEASE DOCKET	_____
WALL MAP	_____
WORKING MAP	_____
LOCATION BOOK	_____

RESERVE: \_\_\_\_\_  
SPECIAL INSTRUCTIONS: \_\_\_\_\_

# WELL RECORD.

W.T.S. Hutson ..... Farm ..... Acres  
 McClellan ..... District Doddridge ..... County ..... W. Va. .... State  
 Well No. 840 .....

Rig Commenced ..... 190 }  
 Rig Completed ..... 190 } **L. Fisher** ..... Contractor.  
 Drilling Commenced 7/1106 ..... 190 }  
 Drilling Completed 8/28/06 ..... 190 } **A. E. Ward** ..... Contractor.

BOOK FORMATION.	TOP.	BOTTOM.	REMARKS.
Conductor		16	
Pittsburg Coal	838	844	
Little Dunkard	1295	1315	
Big Dunkard	1335	1355	
Gas sand	1600	1630	
salt sand	1700	1780	
Water	1750		
Little Lime	2060	2085	
Pencil cave	2085	2092	
Big Lime	2092	2165	
Big Injun	2165	2250	Gas 2220
Fifty foot	2698	2708	
Thrity foot	2860	2880	Gas 2870
Stray sand	2917	2935	Gas 2920 & 2925
Gordon sand	2956	2967	
Gas	2964		
Total depth		3024	

WELL ENDED

WELL BOOK .....  
 LEASE RECORD .....  
 WELL MAP .....  
 WORKING MAP .....  
 COPY SENT .....

8-26-06

### CASING RECORD.

Size	Charged to Well		Put in Well		Pulled Out		Left in Well		Transferred Before Completion		Left at Well, Not in Use	
	Feet	In.	Feet	In.	Feet	In.	Feet	In.	Feet	In.	Feet	In.
10			315		315							
8 1/4			1335									
65/8			2092									
53/16			2697									

Production First 24 hours } ..... Bbls.  
 Approved by W.T.S. Hutson Supt.

Proof—Sum of Three right hand columns equals First or "Charged to Well".  
 Use as many sheets as necessary to make a complete record.  
 In making out this record please use copying ink or an indelible pencil.

API # - 017-1911