

LATITUDE 39° 17' 30"



LONGITUDE 100° 45' 08"

7.5 OGIS topo location

7.5' loc	<u>0.985</u>	15' loc	<u>3.865</u>
	<u>0.72W</u>	(calc.)	<u>0.72W</u>

Company 384

Farm W.G. Dent

Elev. 970' - 7.5 topo - k/a 315193  
Centerpoint SW

Quad SMITHBORG 7 1/2'

County DODDRIDGE

District GRANT

WELL LOCATION MAP

File No. 017-1919

# HOPE NATURAL GAS COMPANY.

## LOCATION FOR WELL No. 1426


*Saline* DISTRICT

On *W. S. Dent* Farm, on waters of *Buckeye Fork*  
*Grant* District, *Doddridge* County, West Virginia

Lease No. *10091* Acres ..... N. .... S. *12* E. *1/4* W. *4*

Scale, one inch equals *80 Poles* Sent to *N.Y.C. 9-14-1909*

Location to be *600 feet from E. S. Taylor farm line and 400 feet from the creek*

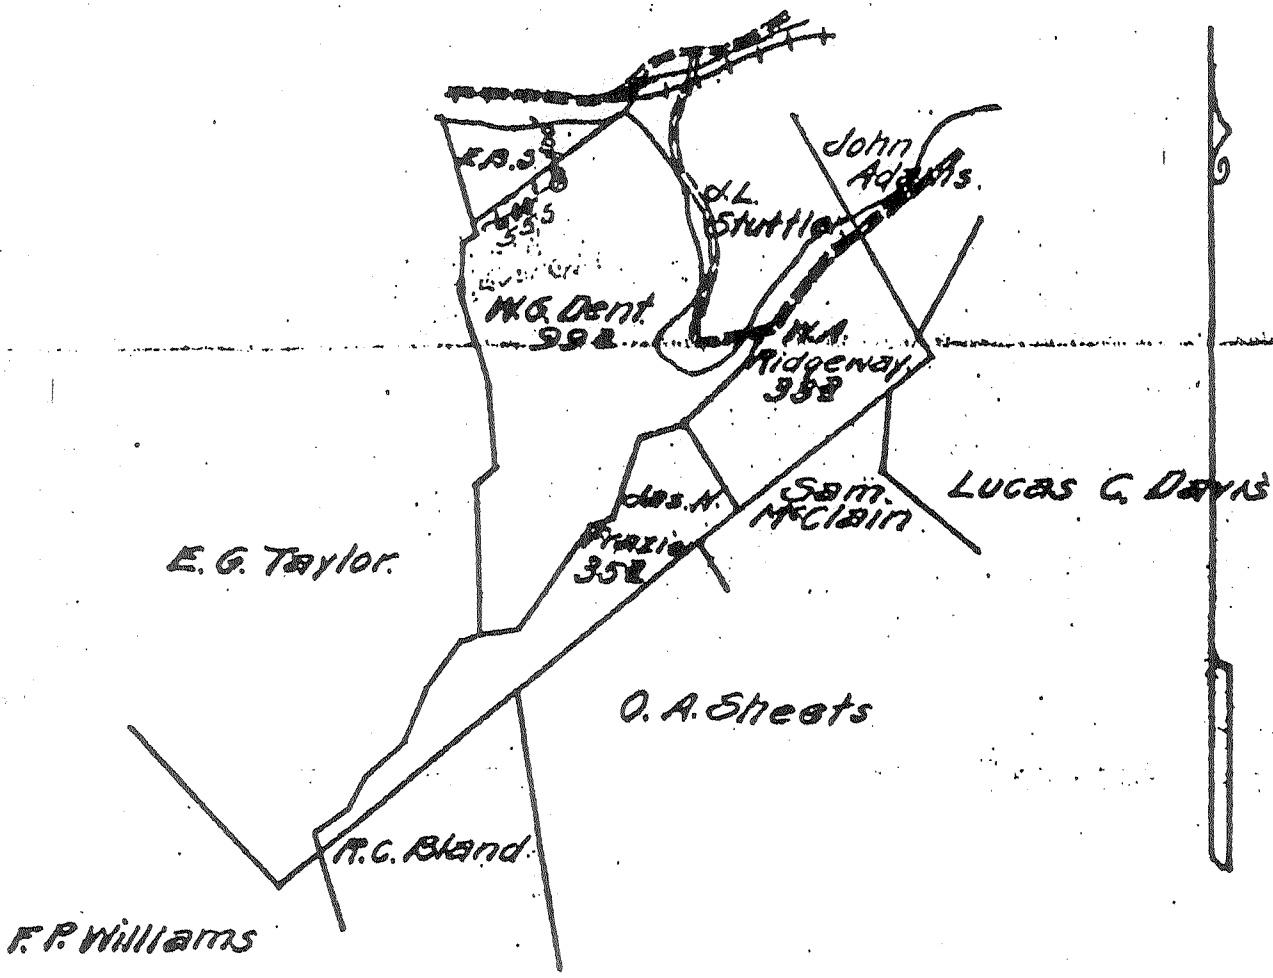

*API - 017 - 1919*

ENTERED  
LINE MAP  
*11-26-1909*  
BY *J. G. L.*

ENTERED
WELL BOOK
LEASE RECORD
LEASE DOCKET
WALL MAP <i>12-31-7-28</i>
WORKING MAP
LOCATION BOOK

RESERVE *Five acres around the buildings*

SPECIAL INSTRUCTIONS *Complete well on or before Nov. 28, 1909.*

Location made *9-21-1909* by *J.P. McClintock* As per plat, except as noted. On field map *9-23-1909* Returned to Pittsburgh *SEP 28 1909*

Location changed on account of *Deep Ravine*  
Authorized by *Jno. G. New* Date *4-23-1909* Signed *W.H. Bradley*

# WELL RECORD.

*W. J. Seely* Farm *99* Acres  
 District *Brad* County *W. Va.* State  
 Well No. *1426*  
 Rig Commenced *Oct 10 1909*  
 Rig Completed *Oct 15 1909*  
 Drilling Commenced *Oct 21 1909*  
 Drilling Completed *Dec 16 1909*  
*H. M. Gas Co.* Contractor.  
*J. S. Wright* Contractor.

ROCK FORMATION.	TOP	BOTTOM.	REMARKS.
<i>Limestone</i>	16		<i>1-8 1/4" Steel Shoe</i>
<i>Pittsburg Coal.</i>	400	400	<i>1-8 1/4" x 10 B. H. Pick.</i>
<i>Big Sandstone</i>	870	895	<i>1-6 5/8" x 8 1/4" B. H. Pick.</i>
<i>Big " "</i>	925	955	
<i>Big Sand</i>	1030	1100	<i>Steel Line Measurements</i>
<i>First part Sand</i>	1190	1250	<i>at 925-1030-1170-1195</i>
<i>Second " "</i>	1260	1375	<i>and at 1715 Bottom of</i>
<i>Marble</i>	1650	1700	<i>6 5/8" Casing.</i>
<i>Big Drift</i>	1770	1824	
<i>Gas Put in</i>		1795	
<i>Total Depth</i>		1824	<i>Water at 1824</i>
			<i>Drillers:</i>
			<i>O. E. Blackwood.</i>
			<i>J. W. Phillips.</i>
			<i>H. E. Ruderwood.</i>
			<i>J. F. Ruderwood.</i>
			<i>10" Csg left in to protect well.</i>

ARI-017-1919

CASING RECORD.												
Size.	Charged to Well.		Put in Well.		Pulled Out.		Left in Well.		Transferred Before Completion.		Left at Well, Not in Use.	
	Feet.	In.	Feet.	In.	Feet.	In.	Feet.	In.	Feet.	In.	Feet.	In.
<i>10</i>	<i>313</i>		<i>313</i>					<i>313</i>			-	-
<i>8 1/4</i>	<i>1514</i>		<i>1204</i>					<i>1204</i>		<i>310</i>	-	-
<i>6 5/8</i>	<i>1984</i>		<i>1715</i>					<i>1715</i>		<i>269</i>	-	-

Production First 24 hours *17000000*  
 Approved by *J. Campbell* Supt.

Note—Sum of three right hand columns equals first or "Charged to Well."  
 Use as many sheets as necessary to make a complete record.  
 In making out this record please use copying ink or an indelible pencil.