


LATITUDE 39°20'00"

00°04'08" LONGITUDE

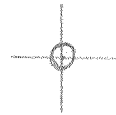

7'5 OGIS topo location

7.5' loc $\frac{2.365}{0.88W}$

15' loc $\frac{2.365}{0.88W}$
(calc.)

Company _____

Farm _____

Elev. 860' - 7.5' topo - Ula slsk
Centerpoint SW

Quad SMITHBURG 7 1/2'

County DODDRIE

District GRANT

WELL LOCATION MAP

File No. 017-1929

HOPE NATURAL GAS COMPANY.

LOCATION FOR WELL No. 1940

DISTRICT


HOPE NATURAL GAS COMPANY

Galena Farm, on waters of *Morgan Run*
Kenney Lot District, *Doddridge* County, West Virginia.

Lease No. *22336* Acres..... N..... S. *10* E.....

Scale, one inch equals *80 Poles* Sent to *N.Y.C. 7-23-1910*

Location to be *100' from county Road on North and 13' from Martha B. Smith on the East.*

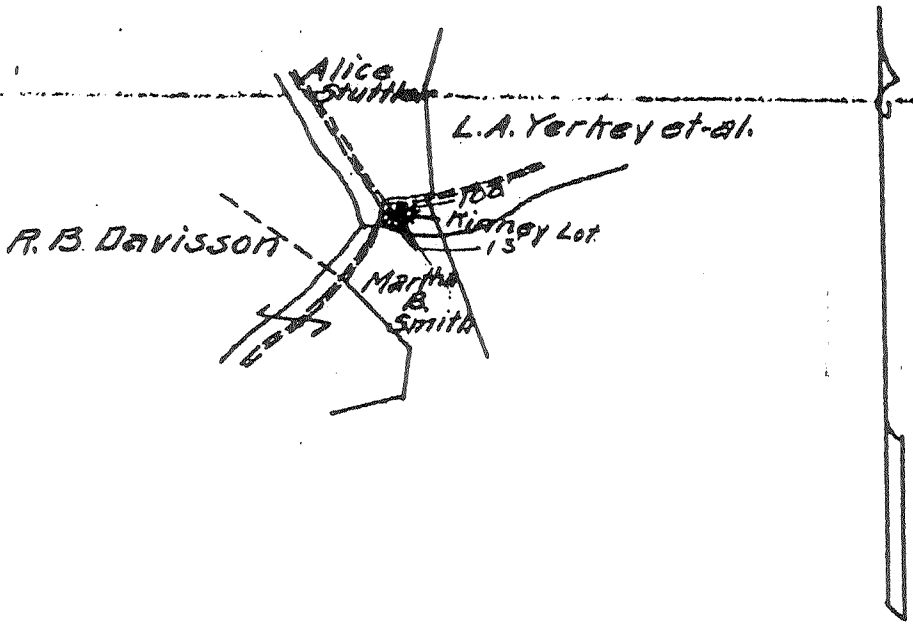

Permit no. - 017 - 1929.

RESERVE.....

SPECIAL INSTRUCTIONS *Purchased from Latham, Stutter and Co*

July 25, 1910 at Kenney Farm Doddridge County West Virginia

Location made *28-10* by *T.S. Lang* As per plat, except as noted. On field map.

8-8-10 Returned to Pittsburgh *8-8-10*

Location changed on account of.....
Authorized by..... Date..... 1..... Signed.....

MURE NATURAL GAS COMPANY

ORIGINAL WELL RECORD

FARM **H. W. Kinney - Lot** WELL No. **1940**
Grant DIST. **Doddridge** CO. **W. Va.**
 DRILLING COMMENCED **Well purchased**
 DRILLING COMPLETED **No record.**
 CONTRACTOR **No record**

Formation	Top	Bottom	Formation	Top	Bottom
Native Con.			Saxon		
Pgh. Con.	305				
Little Dunkard			Saxon		
Big Dunkard	815		Early		
Gas Sand	925	1005	Fifty Feet		
1st Soft Sand	1150	1270	Thirty Feet		
2d Soft Sand	1325	1425	Gordon Stray		
Mazon	1470	1495	Gordon		
Gas	1475		Fourth		
Little Lime	1585	1600	Fifth		
Pease Cove			Saxon		
Big Lime	1625	1695			
			Bayard		
Big Limestone	1695	1795			
			Total Depth	1884	

Casing Size	Put in Well		Pulled Out		Left in Well	
	Feet	Inches	Feet	Inches	Feet	Inches
10 INCH						
10 INCH	112	-	112	-	None	
8 1/4 INCH	820	-	820	-	None	
8 5/8 INCH	1540	-	None		1540	
8 3/8 INCH						

Have Driller O. K. for Amount of Hole Drilled by them

Note:- This well purchased July 25 1910 and this is the only record found in Salem District's files.

Well purchased from Latham Stutler & Co.

OVER

Permit NO. - 017-1929