


LATITUDE $39^{\circ} 20' 00''$

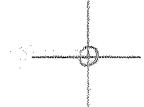

LONGITUDE $80^{\circ} 37' 30''$

7'5 OGIS topo location

7.5' loc. 0.175
1.56W

15' loc 0.175
(calc.) 3.79W

Company _____

Farm _____

Ele. 1060' - 7.5' topo - 4th 315/93
Centarpoint SC

Quad SMITHBURG 7 1/2'

County DOOPRIDGE

District GRANT

WELL LOCATION MAP

File No. 017-1930

HOPE NATURAL GAS COMPANY.

LOCATION FOR WELL No. 2024


11

Oglebay DISTRICT

On D/F Fredericktown Farm, on waters of Big Hazel Creek
 Grant District Ooldridge County, West Virginia
 Lease No. 18139 Acres 16 N S. 8 E. W. 3
 Scale, one inch equals 80 Paces Sent to W. Y. C. 10-15-1910

Location to be 500 feet from Phoebe Benedict farm line
 and 700 feet from Felix Davis farm line
 675

34

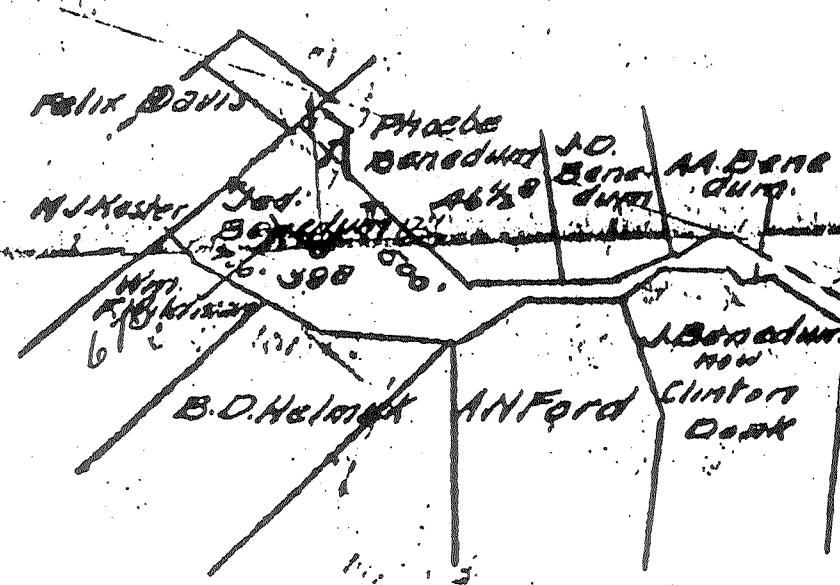

API - 017-1930

RESERVE Four hundred feet on each side of well-trace

SPECIAL INSTRUCTIONS Complete wells over and before

Dec 2 1911

Location made 10-18-10 by T. Lange As per plat, except as noted. On field map

10-19-10 Returned to Pittsburgh 10-19-10

Location changed on account of damage 10-19-10

Authorized by J. B. Brown Date 10-19-10 Signed R. B. Brown

