

WW-7
8-30-06



West Virginia Department of Environmental Protection
Office of Oil and Gas

WELL LOCATION FORM: GPS

API: 47-017-02027 WELL NO.: 394

FARM NAME: Doak, O.E.

RESPONSIBLE PARTY NAME: Diversified Production LLC

COUNTY: Doddridge DISTRICT: Grant

QUADRANGLE: Smithburg

SURFACE OWNER: Danny R. Groover

ROYALTY OWNER: Diversified Production LLC

UTM GPS NORTHING: 4,357,809.8

UTM GPS EASTING: 526,634.1 GPS ELEVATION: 920'

The Responsible Party named above has chosen to submit GPS coordinates in lieu of preparing a new well location plat for a plugging permit or assigned API number on the above well. The Office of Oil and Gas will not accept GPS coordinates that do not meet the following requirements:

1. Datum: NAD 1983, Zone: 17 North, Coordinate Units: meters, Altitude: height above mean sea level (MSL) – meters.
2. Accuracy to Datum – 3.05 meters
3. Data Collection Method:

Survey grade GPS : Post Processed Differential


Real-Time Differential

Mapping Grade GPS : Post Processed Differential

Real-Time Differential

4. Letter size copy of the topography map showing the well location.

I the undersigned, hereby certify this data is correct to the best of my knowledge and belief and shows all the information required by law and the regulations issued and prescribed by the Office of Oil and Gas.

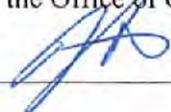
 Signature _____ Director Production _____ 11/5/2021 _____
 Title Date

RECEIVED
 Office of Oil and Gas
 NOV 15 2021
 WV Department of Environmental Protection





Diversified Gas & Oil
Corporation
100 Diversified Way
Pikeville KY, 41051

47-017-02027

Plugging Map

Legend

- Well
- Access Road
- Pits
- Pad
- Public Roads

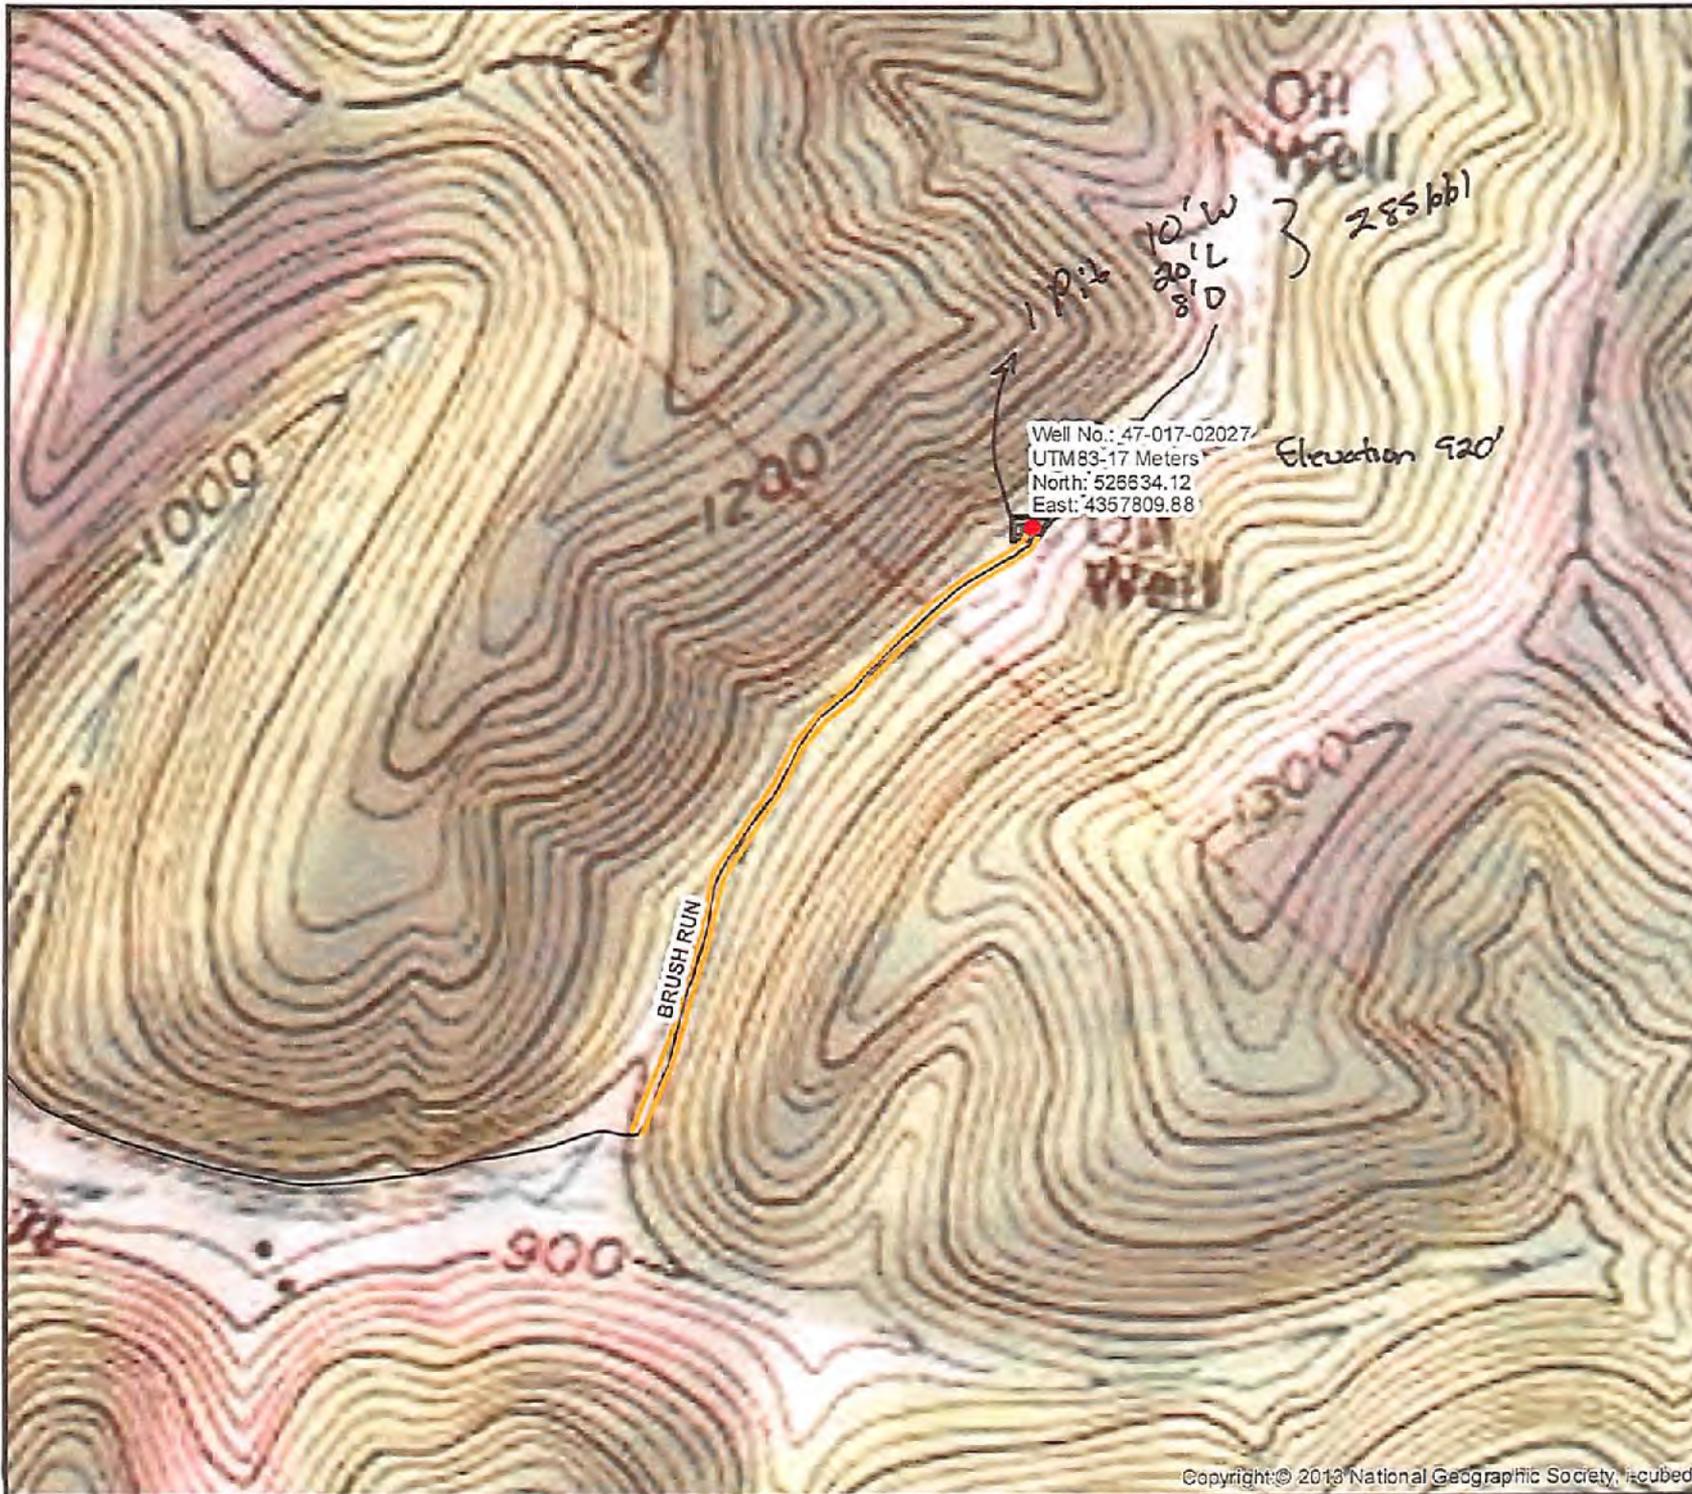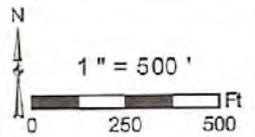

47-017-02027 P