


9/28/87

5950

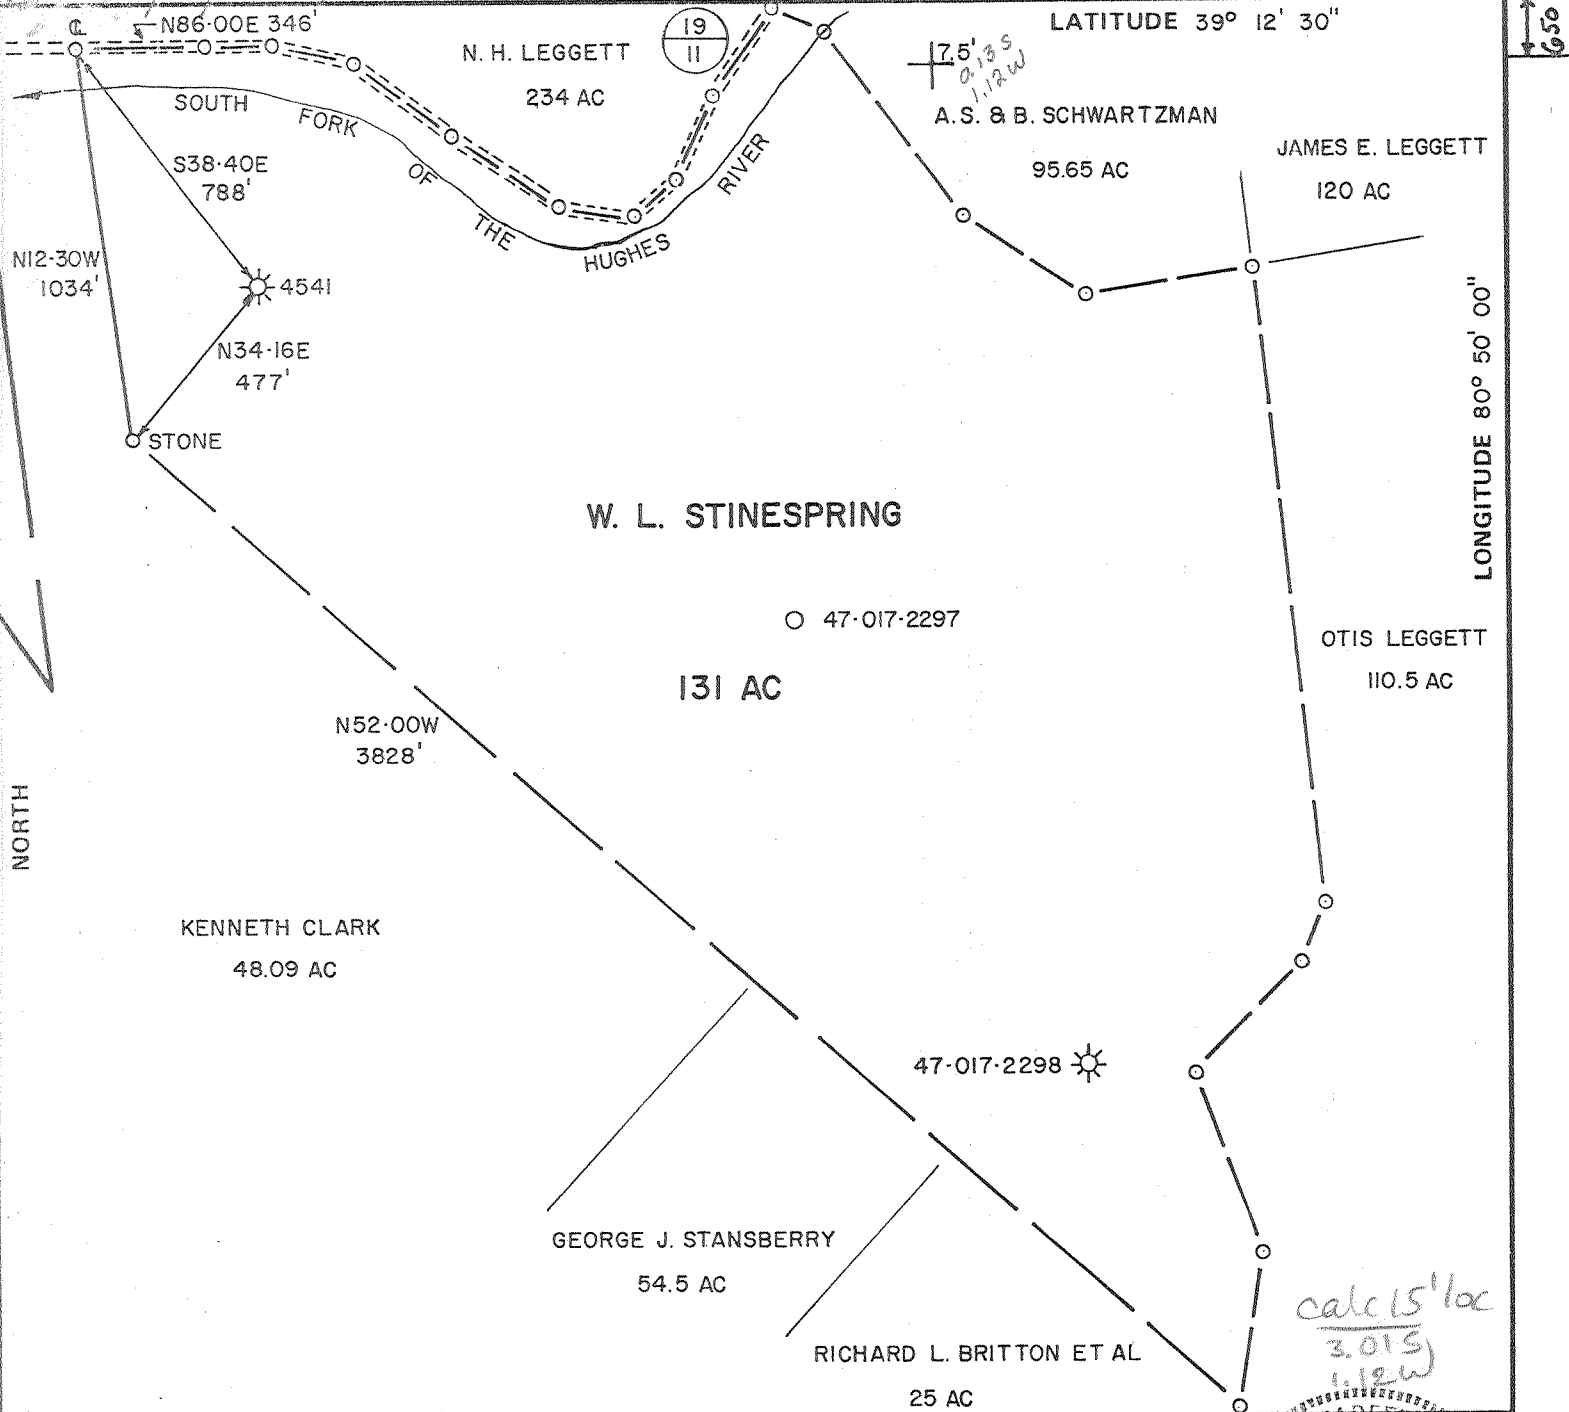

FILE NO. _____
 DRAWING NO. _____
 SCALE 1" = 500'
 MINIMUM DEGREE OF ACCURACY 1 IN 200
 PROVEN SOURCE OF ELEVATION BM 824'

I THE UNDERSIGNED, HEREBY CERTIFY THAT THIS PLAT IS CORRECT TO THE BEST OF MY KNOWLEDGE AND BELIEF AND SHOWS ALL THE INFORMATION REQUIRED BY LAW AND THE REGULATIONS ISSUED AND PRESCRIBED BY THE DEPARTMENT OF MINES.
 (SIGNED) Louis A. Kappeler
 R.P.E. 6302 L.I.S. _____

LOUIS A. KAPPLER - O.R.G.E.
 REGISTERED
 No. 6302
 STATE OF WEST VIRGINIA
 PROFESSIONAL ENGINEER
 PLACE SEAL HERE

(+) DENOTES LOCATION OF WELL ON UNITED STATES TOPOGRAPHIC MAPS
 FORM IV-6 (8-78)

DATE 7/9/87, 19____
 OPERATOR'S WELL NO. 4541
 API WELL NO. 47-017-2038
 STATE 47 COUNTY 017 PERMIT 2038

STATE OF WEST VIRGINIA
 DEPARTMENT OF MINES
 OIL AND GAS DIVISION

WELL TYPE: OIL ___ GAS X LIQUID INJECTION ___ WASTE DISPOSAL ___
 (IF "GAS,") PRODUCTION X STORAGE ___ DEEP ___ SHALLOW ___
 LOCATION: ELEVATION 998' WATER SHED SOUTH FORK OF THE HUGHES RIVER
 DISTRICT SOUTHWEST COUNTY DODDRIDGE
 QUADRANGLE OXFORD, W.V./HOLBROOK NE 54-12 NC

SURFACE OWNER JUDITH STEIN ACREAGE 89.68
 OIL & GAS ROYALTY OWNER W. L. STINESPRING ET UX LEASE ACREAGE 131
 LEASE NO. 13358

PROPOSED WORK: DRILL ___ CONVERT ___ DRILL DEEPER ___ REDRILL ___ FRACTURE OR STIMULATE ___ PLUG OFF OLD FORMATION ___ PERFORATE NEW FORMATION ___ OTHER PHYSICAL CHANGE IN WELL (SPECIFY) _____

PLUG AND ABANDON X CLEAN OUT AND REPLUG ___
 TARGET FORMATION BIG INJUN ESTIMATED DEPTH 2062'
 WELL OPERATOR EQUITABLE GAS COMPANY DESIGNATED AGENT GARY HOY
 ADDRESS 420 BLVD OF THE ALLIES ADDRESS BOX 1550
PITTSBURGH, PA. 15219 CLARKSBURG, W.V. 26301

OCT 5 1987

RECEIVED
MAY 16 1988

DIVISION OF OIL & GAS
DEPARTMENT OF ENERGY

AFFIDAVIT OF PLUGGING AND FILLING WELL

AFFIDAVIT SHOULD BE MADE IN TRIPLICATE, one copy mailed to the Division, one copy to be retained by the Well Operator and the third copy (and extra copies if required) should be mailed to each coal operator at their respective addresses.

<u>Coal Operator or Owner</u>	<u>Equitable Gas</u>
<u>Address</u>	<u>Name of Well Operator</u>
<u>Coal Operator or Owner</u>	<u>P.O. Box 1550, Clarksburg, WV 26301</u>
<u>Address</u>	<u>Complete Address</u>
<u>Coal Operator or Owner</u>	19
<u>Address</u>	<u>WELL AND LOCATION</u>
<u>Lease or Property Owner</u>	<u>Southwest</u> District
<u>Address</u>	<u>Doddridge</u> County
	<u>WELL NO. 47-017-2038</u>

W.L. Stinespring 4541 Farm

STATE INSPECTOR SUPERVISING PLUGGING Mike Underwood

AFFIDAVIT

STATE OF WEST VIRGINIA,
County of Gilmer ss:

James Myers and Argene Stalnaker

being first duly sworn according to law depose and say that they are experienced in the work of plugging and filling oil and gas wells and were employed by Gene Stalnaker Inc., well operator, and participated in the work of plugging and filling the above well, that said work was commenced on the 2nd day of May, 19 88, and that the well was plugged and filled in the following manner:

Sand or Zone Record Formation	Filling Material	Plugs Used Size & Kind	Casing	
			CSG PULLED	CSG LEFT IN
Shale	Gel	2062-1930 3"	1976	86
Sand	Cement	1930-1830 7"	1216	665
Shale	Gel	1830-1220		
Sand	Cement	1220-1040 8"	902	149
Shale	Gel	1040-915		
Sand	Cement	915-845		
Shale	Gel	845-335		
Sand	Cement	335-265 10"	56	229
Shale	Gel	265- 65		
Dirt Rock	Cement	65-0		
Coal Seams				
(Name)		7" pipe 30" above ground		
(Name)		level.		
(Name)				
(Name)				

[Signature] 5/18/88
Description of Monument

and that the work of plugging and filling said well was completed on the 12th day of May, 19 88.

And further deponents saith not.


James H. Myers
Argene R. Stalnaker

Sworn to and subscribed before me this 13th day of May, 19 88.

Barbara C. Smith
Notary Public MAY 20 1988

My commission expires:

9 November 1991

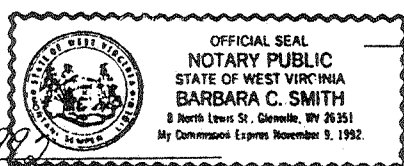

Permit No. 47-017-2038