

WW-7  
8-30-06



West Virginia Department of Environmental Protection  
Office of Oil and Gas  
**WELL LOCATION FORM: GPS**

API: 47-017-02088 WELL NO.: WV 604869 (J. Leeson #4869)

FARM NAME: Leeson

RESPONSIBLE PARTY NAME: EQT Production Company

COUNTY: Doddridge DISTRICT: South West

QUADRANGLE: Oxford 7.5'

SURFACE OWNER: Coastal Forest Resources Co.

ROYALTY OWNER: Huff Family Trust Decedents Trust B, et al.

UTM GPS NORTHING: 4331907

UTM GPS EASTING: 516477 GPS ELEVATION: 354 m (1163 ft)

The Responsible Party named above has chosen to submit GPS coordinates in lieu of preparing a new well location plat for a plugging permit or assigned API number on the above well. The Office of Oil and Gas will not accept GPS coordinates that do not meet the following requirements:

1. Datum: NAD 1983, Zone: 17 North, Coordinate Units: meters, Altitude: height above mean sea level (MSL) – meters.
2. Accuracy to Datum – 3.05 meters
3. Data Collection Method:

Survey grade GPS     : Post Processed Differential       
Real-Time Differential     

Mapping Grade GPS X: Post Processed Differential X  
Real-Time Differential     

4. Letter size copy of the topography map showing the well location.

I the undersigned, hereby certify this data is correct to the best of my knowledge and belief and shows all the information required by law and the regulations issued and prescribed by the Office of Oil and Gas.

  
Signature

PS # 2180  
Title

Received  
Office of Oil & Gas  
Date 9/20/14  
NOV 20 2014

1702088P

Topo Quad: Oxford 7.5'

Scale: 1" = 2000'

County: Doddridge


Date: September 29, 2014

District: South West

Project No: 67-30-00-08

47-017-02088 WV 604869 (J. Leeson #4869)

Topo

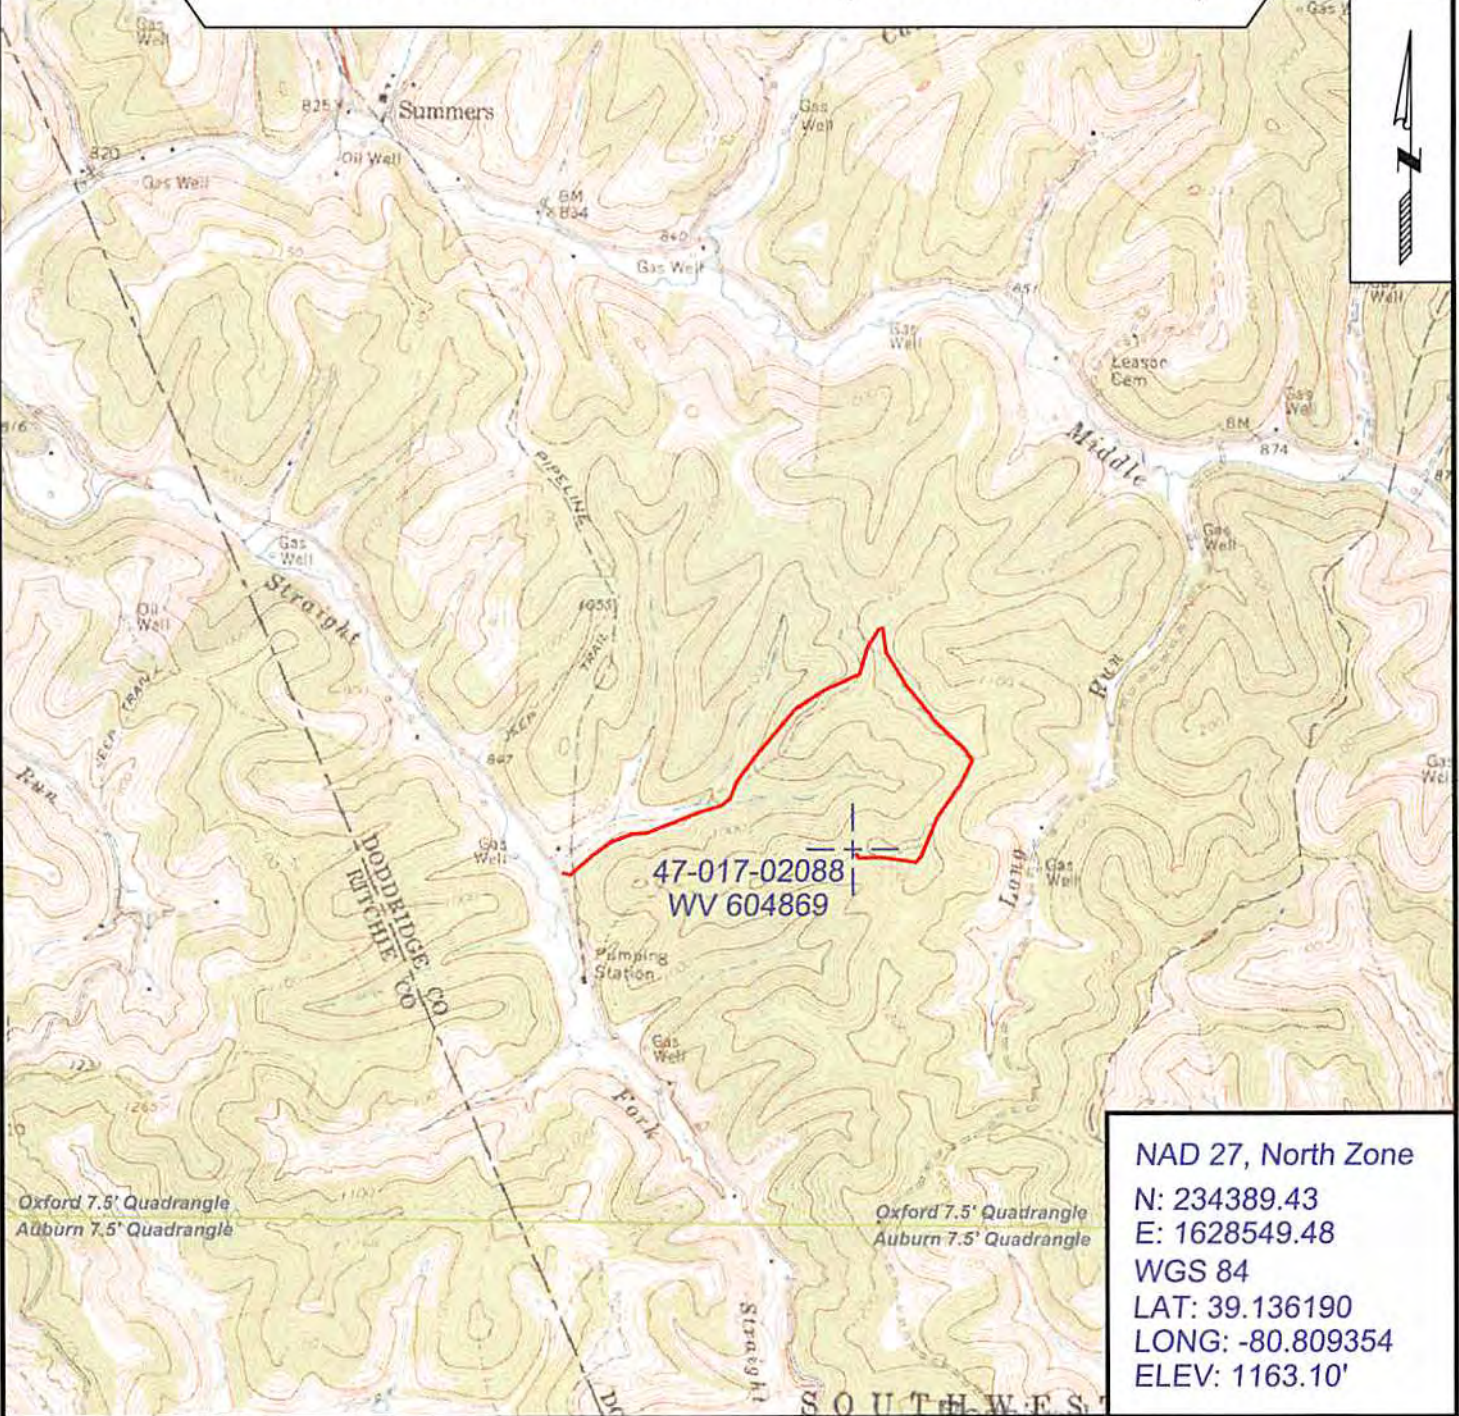

47-017-02088  
WV 604869

NAD 27, North Zone  
 N: 234389.43  
 E: 1628549.48  
 WGS 84  
 LAT: 39.136190  
 LONG: -80.809354  
 ELEV: 1163.10'



SURVEYING AND MAPPING SERVICES PERFORMED BY:  
**ALLEGHENY SURVEYS, INC.**  
 1-800-482-8606  
 237 Birch River Road  
 Birch River, WV 26610  
 PH: (304) 649-8606  
 FAX: (304) 649-8608

PREPARED FOR:  
 Office of Oil & Gas  
**EQT Production Company**  
 NOV 20 2014 P.O. Box 280  
 Bridgeport, WV 26330