


SHIRLEY DANIEL

LATITUDE $39^{\circ}17'30''$
 ~~$39^{\circ}20'15''$~~

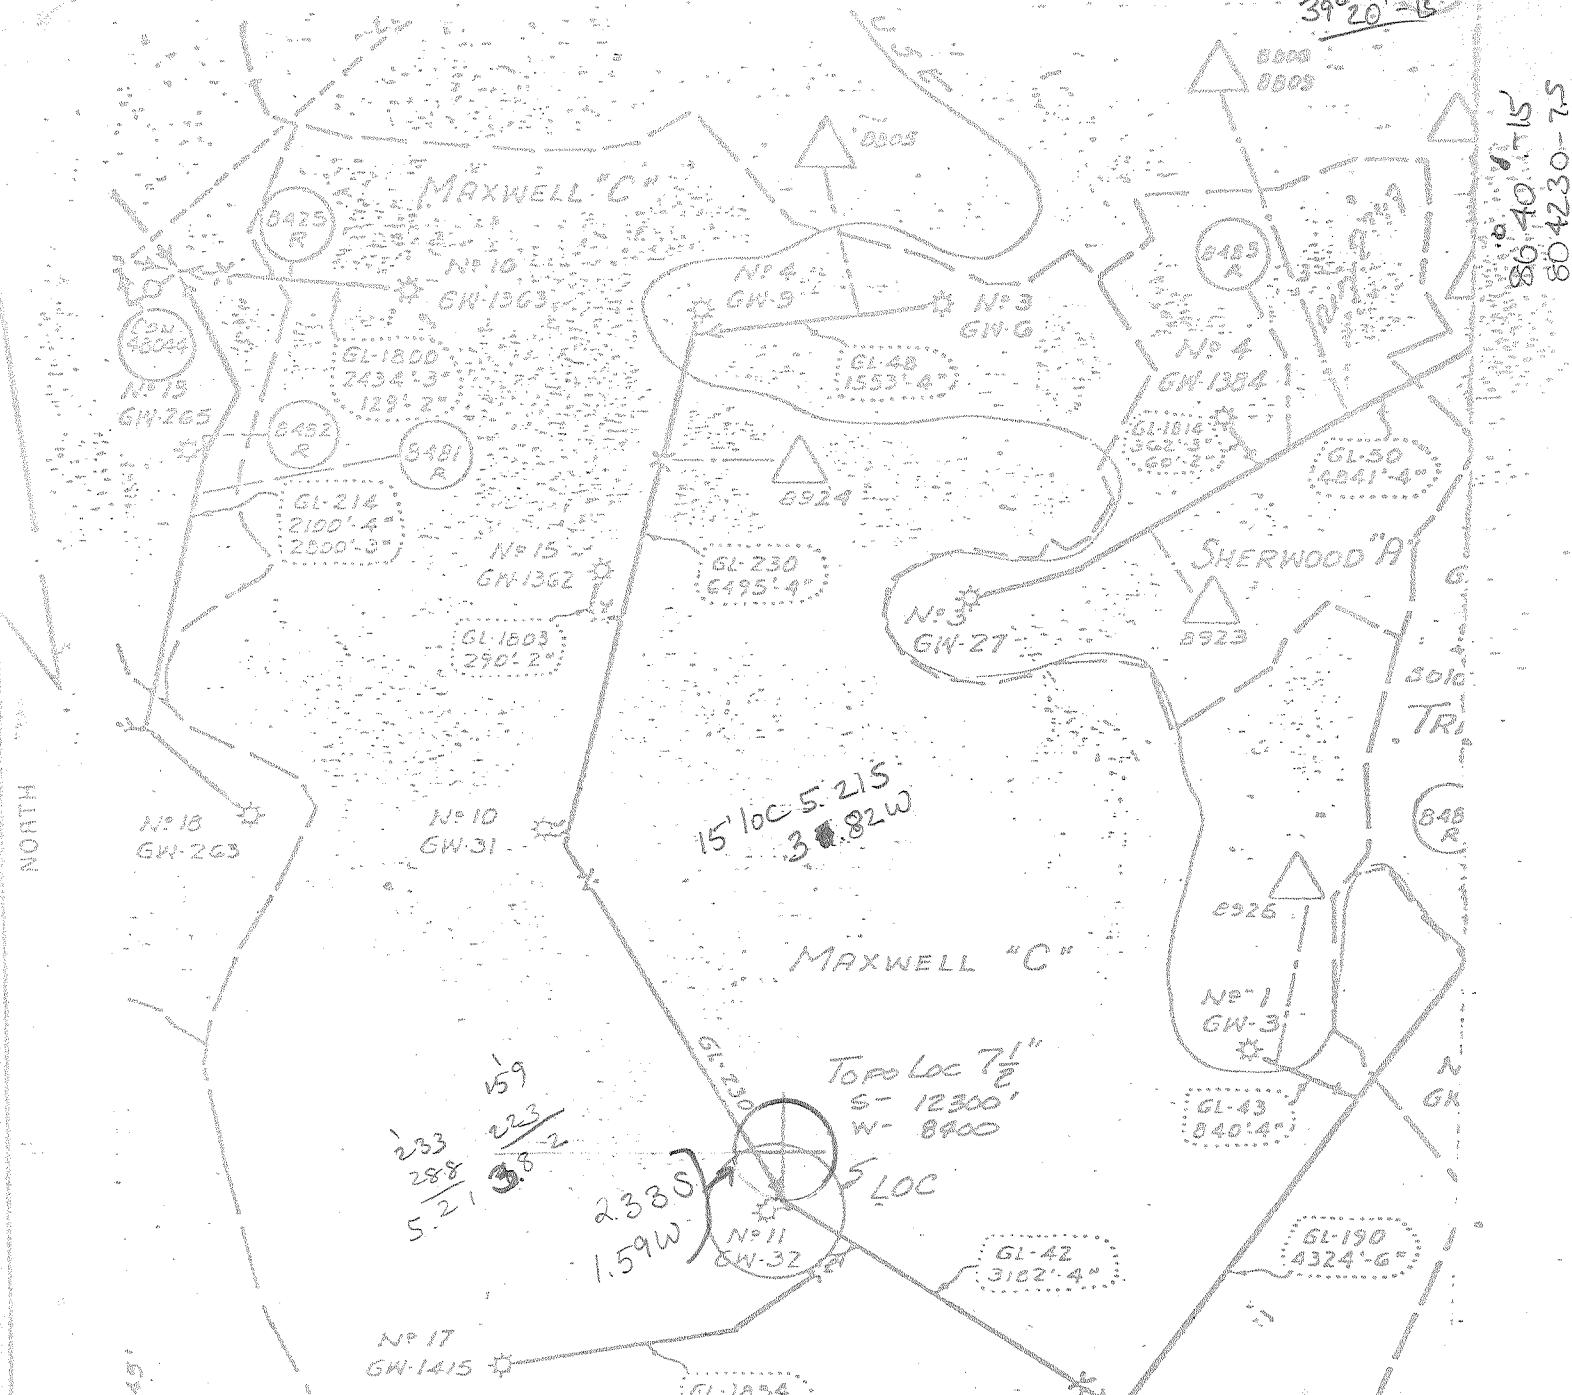

FILE NO.
DRAWING NO.
SCALE 1" = 1320
MINIMUM DEGREE OF
ACCURACY
PROVEN SOURCE OF
ELEVATION

I THE UNDERSIGNED, HEREBY CERTIFY THAT
THIS PLAT IS CORRECT TO THE BEST OF MY
KNOWLEDGE AND BELIEF AND SHOWS ALL THE
INFORMATION REQUIRED BY LAW AND THE REGU-
LATIONS ISSUED AND PRESCRIBED BY THE DEPART-
MENT OF MINES.
(SIGNED) *Donald J. Ray*

PLACE SEAL HERE

(+) DENOTES LOCATION OF
WELL ON UNITED STATES
GEOGRAPHIC MAPS

FORM IV-6



STATE OF WEST VIRGINIA
DEPARTMENT OF MINES
OIL AND GAS DIVISION

WELL TYPE: OIL GAS LIQUID INJECTION WASTE DISPOSAL

WELL TYPE: PRODUCTION STORAGE DEEP SHALLOW
LOCATION: ELEVATION 975' WATER SHED MEATHOUSE FORK
DISTRICT NEW MILTON COUNTY RODRIDGE
QUADRANGLE SMITHBURG 7½ Centerpoint SW

SURFACE OWNER _____ ACREAGE _____
OIL & GAS ROYALTY OWNER MAXWELL 'C' 1 LEASE ACREAGE.

LEASE NO. _____
PROPOSED WORK: DRILL ____ CONVERT ____ DRILL DEEPER ____ REDRILL ____ FRACTURE OR
STIMULATE ____ PLUG OFF OLD FORMATION ____ PERFORATE NEW
FORMATION ____ OTHER PHYSICAL CHANGE IN WELL (SPECIFY) _____
F.E.R.C. FILING

PLUG AND ABANDON — CLEAN OUT AND REPLUG — Smithton-Flint-Sedalia (99)
TARGET FORMATION ESTIMATED DEPTH
WELL OPERATOR CITIES SERVICE CO. DESIGNATED AGENT SAM J. MATTHEWS
ADDRESS PO BX 873 ADDRESS PO BX 873
CHARLESTON WV 25303 CHARLESTON WV 25303
Shallow Fork 8th Street (123)

MICH 3d' 1922

CB

CONSOLIDATED CARBON COMPANY

RECORD OF LEWIS MAXWELL WELL NO. II.

Contractor J. E. Trainer
 Commenced October 26, 1912
Completed Dec. 4, 1912
 Total Depth 2294 ft.
 Producing gas from.

Maxwell C-11

FORMATION	TOP	BOTTOM
Conductor	16	
Water	60	
Coal	200	204
10" Casing	218	
Little Dunkard	510	680
Big Dunkard	755	800
8 1/2" casing	740	
Gas Sand	840	955
1st Salt Sand	1035	1115
2nd Salt Sand	1135	1220
3rd Salt Sand	1234	1542
Gas	1535	
Gas	1535	1507
Red Rock	1592	1520
Little Lime-	1592	
Pencil Cave	1592	1562
Blue Monday	1592	1574
Big Lime	1574	1683
C-5/8" Casing	1676	
Big Injun Sand	1631	1708
Gas -	1640	
Gantz Sand	1878	1978
50 ft.	2160	2175
Shells	2260	2265
Slate	2265	2273
Gordon Shaly	2273	2287
Gas -	2273	2295
Gordon	2287	2290
Total Depth	2294	

Plumbed with 2" tubing.

R. & L. Collar & nipple 1 ft above Packer

Packer set 410 ft. from Bottom

017-2152