



*Janell*  
11/4/91  
" " "  
3/19/92

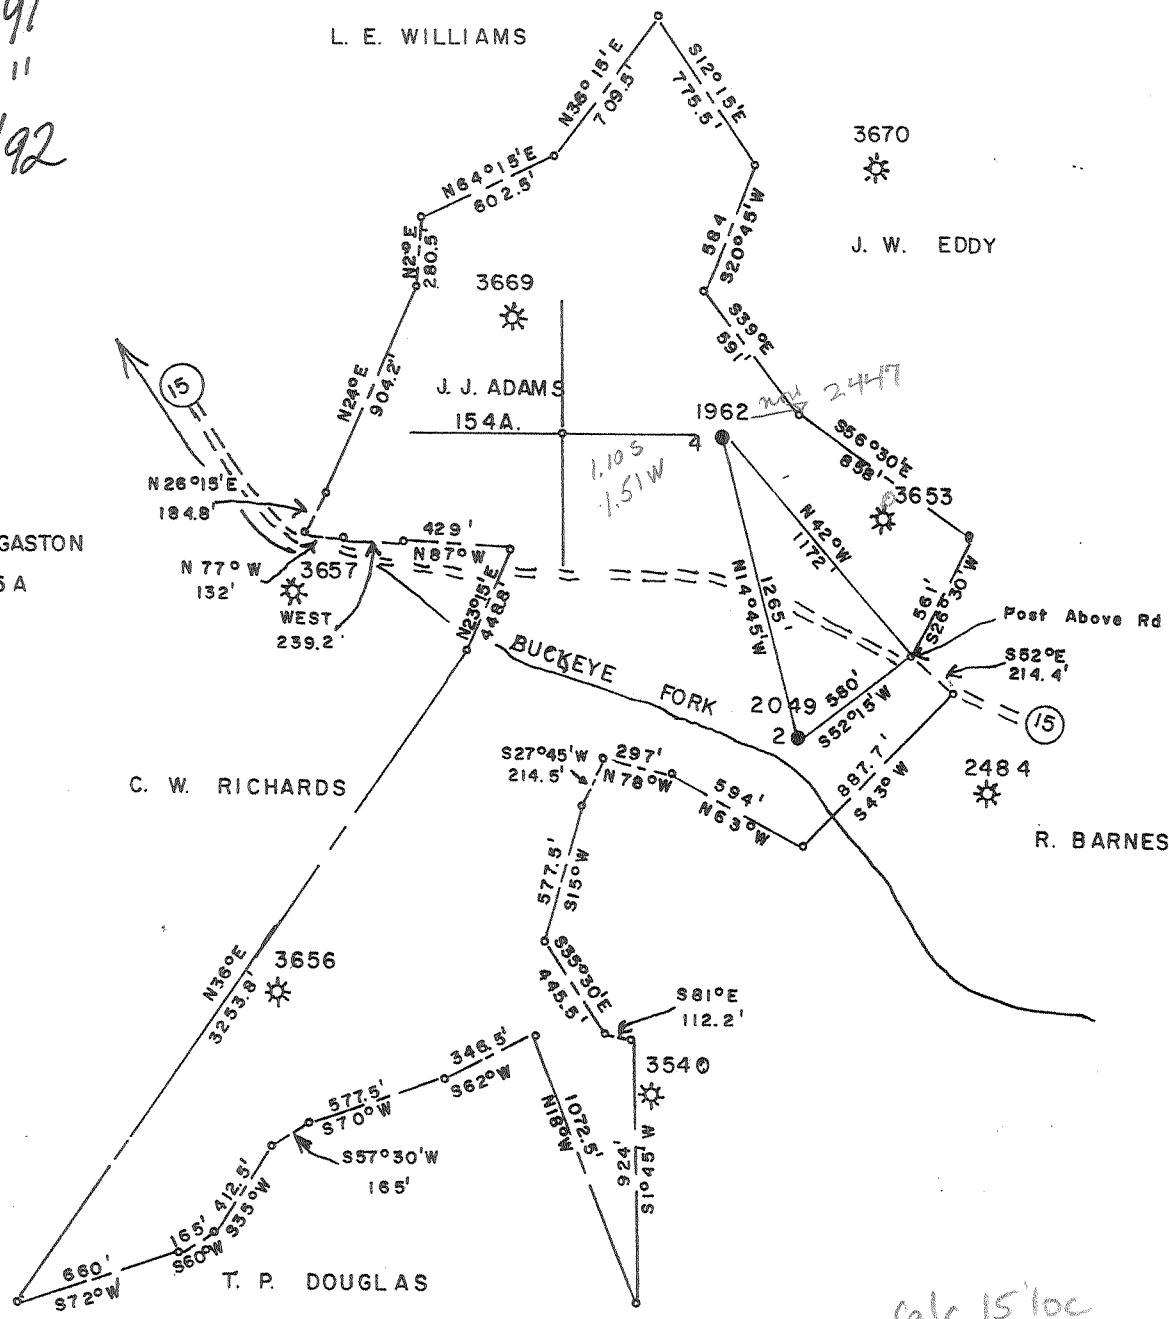

FILE NO. \_\_\_\_\_  
 MAP N18 SQS S15 W1  
 SCALE 1" = 800'  
 MINIMUM DEGREE OF ACCURACY 1/200  
 PROVEN SOURCE OF ELEVATION USGS BM "2JEA"  
1962"

I, THE UNDERSIGNED, HEREBY CERTIFY THAT THIS PLAT IS CORRECT TO THE BEST OF MY KNOWLEDGE AND BELIEF AND SHOWS ALL THE INFORMATION REQUIRED BY LAW AND THE REGULATIONS ISSUED AND PRESCRIBED BY THE DEPARTMENT OF MINES.  
 (SIGNED) Curtis A. Lucas  
 CURTIS A. LUCAS LLS 275

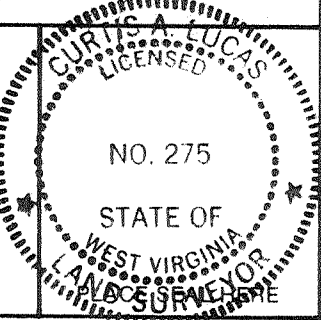

STATE OF WEST VIRGINIA  
 DEPARTMENT OF MINES  
 OIL AND GAS DIVISION



DATE Sept. 22 1991  
 FARM J. J. ADAMS NO. 3  
 API WELL NO. See 017-1937

47 - 017 - 21584  
 STATE COUNTY PERMIT  
Corrected Permit No:  
Not. 017-1962

(+) DENOTES LOCATION OF WELL ON UNITED STATES TOPOGRAPHIC MAPS  
 WELL TYPE: OIL  GAS \_\_\_\_\_ LIQUID INJECTION \_\_\_\_\_ WASTE DISPOSAL \_\_\_\_\_  
 (IF "GAS,") PRODUCTION \_\_\_\_\_ STORAGE \_\_\_\_\_ DEEP \_\_\_\_\_ SHALLOW \_\_\_\_\_  
 LOCATION: ELEVATION 969 WATER SHED BUCKEYE FORK  
 DISTRICT GREENBRIER COUNTY DODDRIDGE  
 QUADRANGLE BIG ISAAC Vadis ne

SURFACE OWNER \_\_\_\_\_ ACREAGE \_\_\_\_\_  
 OIL & GAS ROYALTY OWNER \_\_\_\_\_ LEASE ACREAGE 154  
 LEASE NO. \_\_\_\_\_

PROPOSED WORK: DRILL \_\_\_\_\_ CONVERT \_\_\_\_\_ DRILL DEEPER \_\_\_\_\_ REDRILL \_\_\_\_\_ FRACTURE OR STIMULATE \_\_\_\_\_ PLUG OFF OLD FORMATION \_\_\_\_\_ PERFORATE NEW FORMATION \_\_\_\_\_ OTHER PHYSICAL CHANGE IN WELL (SPECIFY) \_\_\_\_\_

PLUG AND ABANDON  CLEAN OUT AND REPLUG \_\_\_\_\_  
 TARGET FORMATION GORDON ESTIMATED DEPTH 2724  
 WELL OPERATOR CLARENCE W. MUTSCHELKNAUS DESIGNATED AGENT CLARENCE W. MUTSCHELKNAUS  
 ADDRESS P O BOX 351 SALEM WV 26426 ADDRESS P O BOX 351 SALEM WV 26426

Dood 1962-P

STATE OF WEST VIRGINIA  
DIVISION OF ENVIRONMENTAL PROTECTION  
SECTION OF OIL AND GAS

NOT: *delisted*  
017-1962

AFFIDAVIT OF PLUGGING AND FILLING WELL

AFFIDAVIT SHOULD BE IN TRIPLICATE, one copy mailed to the Division, one copy to be retained by the Well Operator and the third copy (and extra copies if required) should be mailed to each coal operator at their respective addresses.

Farm name: MILLS, JEFF Operator Well No.: J.J. ADAMS ~~2~~ 3

LOCATION: Elevation: 969.00 Quadrangle: BIG ISAAC  
District: County: DODDRIDGE  
Latitude: 5800 Feet South of 39 Deg. 15 Min. 0 Sec.  
Longitude 7975 Feet West of 80 Deg. 35 Min. 0 Sec.

Well Type: OIL   x   GAS   x  

Company: Mutschelknaus Oil & Gas Coal Operator   N/A    
P.O. Box 351 or Owner \_\_\_\_\_  
Salem, WV 26426 \_\_\_\_\_

Agent: Mutschelknaus Oil & Gas Coal Operator   N/A    
Permit Issued: 10/09/91 or Owner \_\_\_\_\_

AFFIDAVIT

STATE OF WEST VIRGINIA,  
County of Harrison ss: 234-50-8559 and 232-60-0375

Milford Yoak and Blaine Plauger being first duly sworn according to law depose and say that they are experienced in the work of plugging and filling oil and gas wells and were employed by the above named well operator, and participated in the work of plugging and filling the above well, and Mike Underwood Oil and Gas Inspector representing the Director, say that said work was commenced on the 3rd day of October, 1991, and that the well was plugged and filled in the following manner:

TYPE	FROM	TO	PIPE REMOVED	LEFT
Pulled 2741 ft. of 2" tubing, bailed well dry to 2750, gelled the hole with 2 sacks to 2750, ran 25 sacks of cement through 5" from 2750 to 2532, cut 5" at 2004ft. and pulled through, cut 7" at 1160ft. and pulled.				
ran 25 sacks of cement from 2045 to 1800 ft. pulled 2" tubing back to 1160, broke circulation with 2 1/2 sacks of gel, cement from 1160 to 1060, chase with 1 1/2 sacks of gel, cut 8" at 280ft. but pulled out 320ft. of 8". Ran tubing to 400ft., broke circulation, ran 2 bags of gel, ran 30 bags of cement from 400ft. to 250 ft. Pulled 2" to 200ft. from surface, ran 65 sacks of cement from 200ft. to surface.				

*WJ* 11/5/91

Description of monument: 8 inch pipe with API# on it  
and that the work of plugging and filling said well was completed on the 30th day of October, 1991.

Notary Public  
DAVID M. BISSELL  
RI. 3, BCK 137-D  
BRISQUEPORT, WV 26330  
My Commission Expires APRIL 15, 2001

Blaine Plauger  
Milford Yoak  
David M. Bissell  
Notary Public

Sworn and subscribe before me this 30th day of October, 1991  
My commission expires: April 15th 2001

Oil and Gas Inspector:

0000 2150 P