

Elev. 1050 (topo. est.)

Dodd - 2159
Harrison 2159

Smithburg 7.5' quad
Centerpoint SC

h.l. Smithton-Flint-Sedalia (99)

2159

Form 226
 497
 Road Water
 Right

WELL RECORD.

2159
 [Signature]

Farm _____ Acres _____
 District Wood County W. Va. State _____

Well No. _____
 Rig Commenced _____ 190 _____
 Rig Completed _____ 190 _____
 Drilling Commenced 09/19 190 _____
 Drilling Completed 10/10 190 _____
 Contractor G. H. McFarlin

ROCK FORMATION.	TOP.	BOTTOM.	REMARKS.
Open water			
Open water	680	688	1-8-4 x 6-8 in near bottom
Big Bryum sand	1995	1086	Put in well.
Shale	1086	1098	
lime	1098	1108	
Gas sand	1108	1113	
Wedge drilled		1113	

CASINO RECORD.

Size.	Charged to Well.		Put in Well.		Pulled Out.		Left in Well.		Transferred Before Completion.		Left at Well, Not in Use.	
	Feet	In	Feet	In	Feet	In	Feet	In	Feet	In	Feet	In
10			555		555							
8 1/4			1233				1233					
6 7/8			1100				1100					

Production First 24 hours } _____ Bbls.
 Approved by _____
 Sign. _____

Proof.—Sum of Three right hand columns equals First or "Charged to Well."
 Use as many sheets as necessary to make a complete record.

497

2012

WELL RECORD.

226 10104
 Road Water Farm
 District Wood County W. Va. State

Well No.

Rig Commenced 180

Rig Completed 180 } *Opp. & Co. Contractor.*

Drilling Commenced 180 } *9. H. M. Spain Contractor.*

Drilling Completed 180 }

ROCK FORMATION.	TOP.	BOTTOM.	REMARKS.
<i>Blond water</i>	680	688	<i>1-8 1/4 x 6 1/8 in</i>
<i>Big Dryum sand</i>	1995	2086	<i>near bottom</i>
<i>Shale</i>	2086	2098	<i>Put in Well.</i>
<i>lime.</i>	2098	2108	
<i>Gas sand</i>	2108	2113	
<i>Weyhville</i>		2113	

CASING RECORD.

Size.	Charged to Well.		Put in Well.		Pulled Out.		Left in Well.		Transferred Before Completion.		Left at Well, Not in Use.	
	Feet	In	Feet	In	Feet	In	Feet	In	Feet	In	Feet	In
10			555		555							
8 1/4			1222				1222					
6 1/2			2100				2100					

Production First 24 hours } Bbls.

Approved by _____ Supt.

Proof.—Sum of Three right hand columns equals First or "Charged to Well."
 Use as many sheets as necessary to make a complete record.

017-2159

LOCATION FOR WELL No. 497

Salem DISTRICT

MAY 11 1914

On W. Broadwater Farm, on waters of Long Run


Grant District, Daddridge County, West Virginia.

Lease No. 4298 Acres 113 N. — S. 13 E. — W. 3

Scale, one inch equals 800 feet Sent to

Location to be

31.54, p. 39.

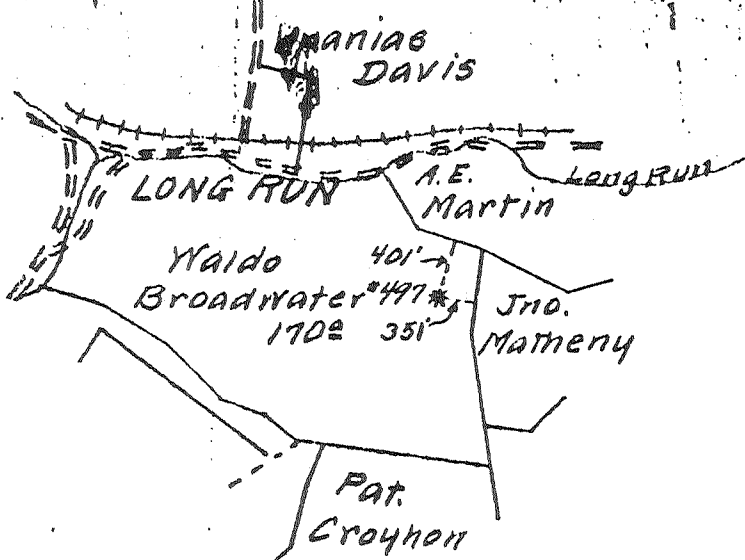

OK ANT B

017-2159

RESERVE

SPECIAL INSTRUCTIONS

Location ^{Meas} ~~marked~~ Oct. 30 1914 by A.C. Perry As per plat, except as noted. On field map.

Returned to Pittsburgh

Location changed on account of

Authorized by Date 1 Signed