

WW-7  
8-30-06



West Virginia Department of Environmental Protection  
Office of Oil and Gas  
WELL LOCATION FORM: GPS

API: 47-017-02328 P WELL NO.: G.B. Chapman #1

FARM NAME: Coffman, Nancy & Ora

RESPONSIBLE PARTY NAME: EXCO Resources (PA), LLC

COUNTY: Doddridge DISTRICT: New Milton

QUADRANGLE: New Milton

SURFACE OWNER: Nancy & Ora Coffman

ROYALTY OWNER: \_\_\_\_\_

UTM GPS NORTHING: 4342470.72m

UTM GPS EASTING: 527432.10m GPS ELEVATION: 256.66 m / 842.06'

The Responsible Party named above has chosen to submit GPS coordinates in lieu of preparing a new well location plat for a plugging permit or assigned API number on the above well. The Office of Oil and Gas will not accept GPS coordinates that do not meet the following requirements:

1. Datum: NAD 1983, Zone: 17 North, Coordinate Units: meters, Altitude: height above mean sea level (MSL) – meters.
2. Accuracy to Datum – 3.05 meters
3. Data Collection Method:  
Survey grade GPS \_\_\_\_: Post Processed Differential \_\_\_\_

Real-Time Differential \_\_\_\_

Mapping Grade GPS X: Post Processed Differential \_\_\_\_

Real-Time Differential X

4. Letter size copy of the topography map showing the well location.



I the undersigned, hereby certify this data is correct to the best of my knowledge and belief and shows all the information required by law and the regulations issued and prescribed by the Office of Oil and Gas.

[Signature]  
Signature

Construction Specialist I  
Title

2-20-13  
Date



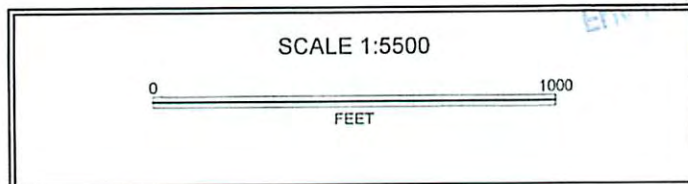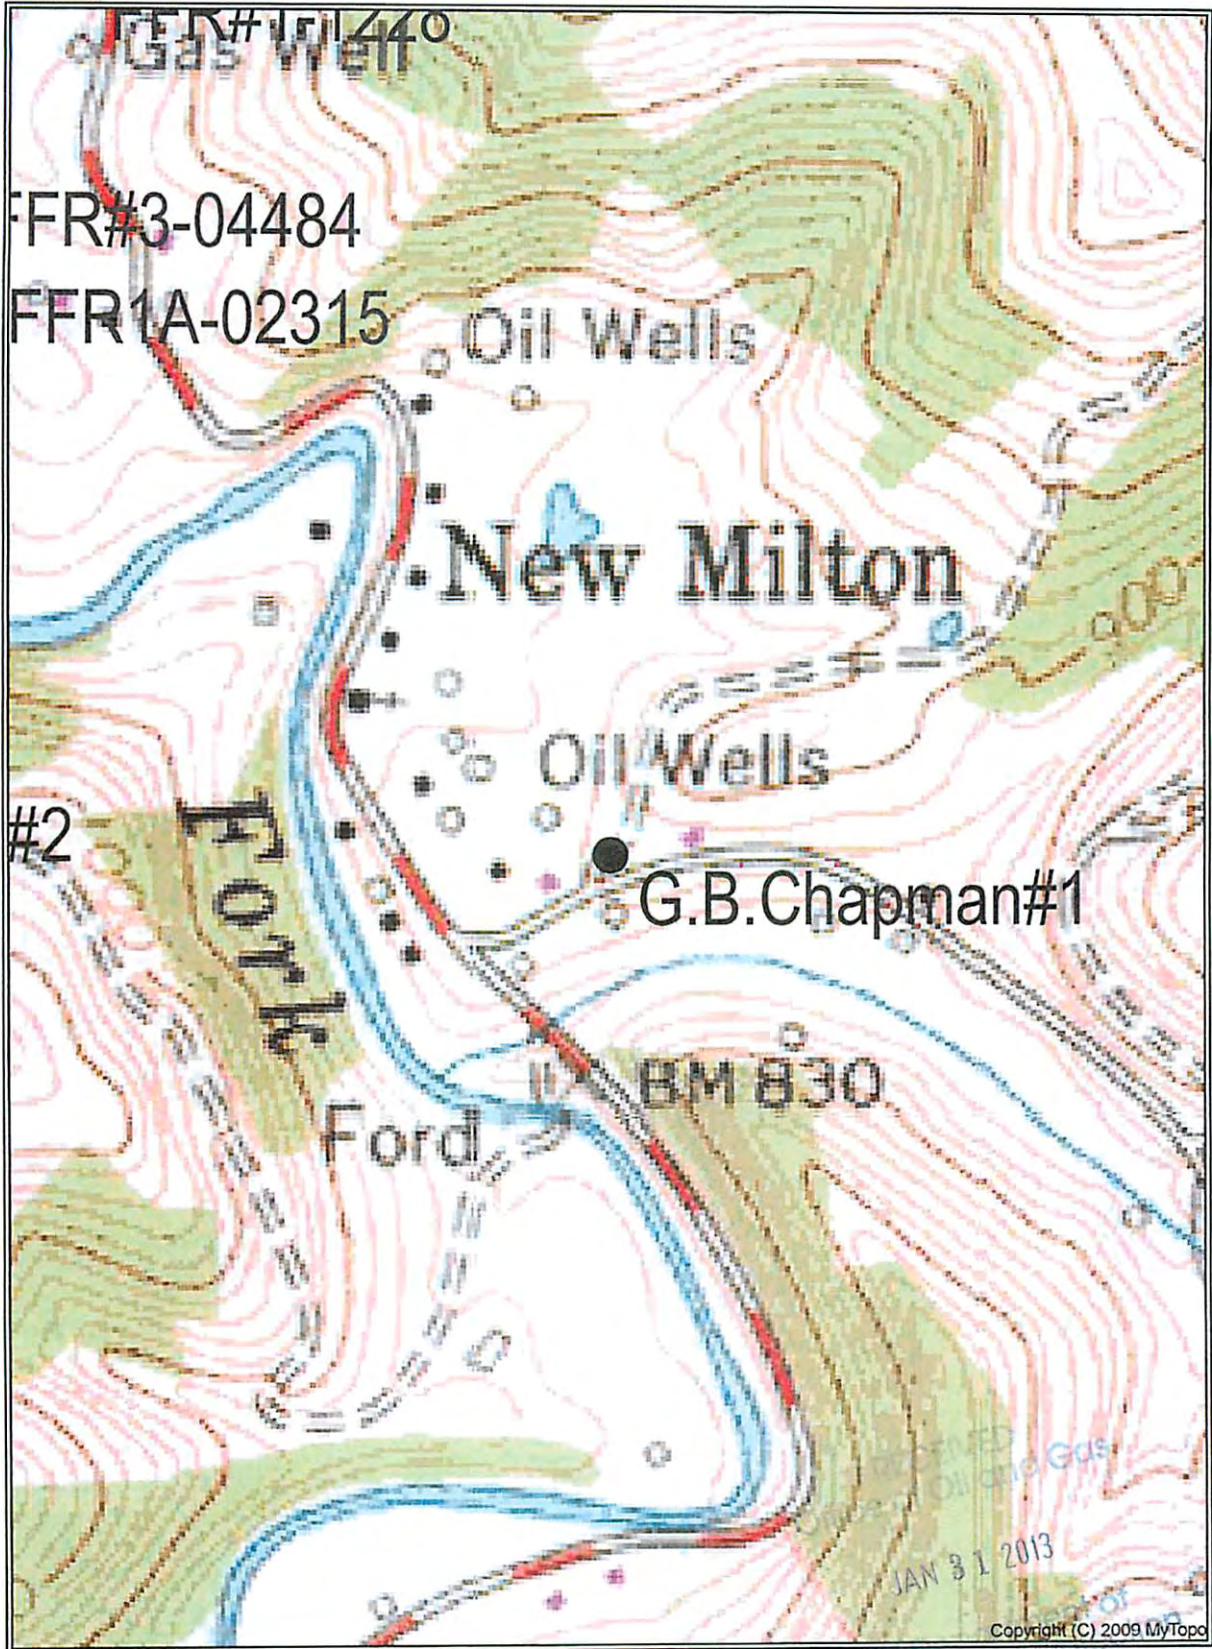

JAN 31 2013  
Copyright (C) 2009 MyTopo  
WV Dept of Environmental Protection