
WW-7 8-30-06



## West Virginia Department of Environmental Protection Office of Oil and Gas

## WELL LOCATION FORM: GPS

<sub>API:</sub> 47-017-02383	well no.: I. Warner #1
FARM NAME: Coffman, Ora & Nancy	
RESPONSIBLE PARTY NAME: EXCO Resources (PA), LLC	
COUNTY: Doddridge	DISTRICT: New Milton
QUADRANGLE: New Milton	
SURFACE OWNER: Ora & Nancy Coffman	
ROYALTY OWNER:	
UTM GPS NORTHING: 4342770.9 m	
	m GPS ELEVATION: 822 ft
The Responsible Party named above has chosen to submit GPS coordinates in lieu of preparing a new well location plat for a plugging permit or assigned API number on the above well. The Office of Oil and Gas will not accept GPS coordinates that do not meet the following requirements:  1. Datum: NAD 1983, Zone: 17 North, Coordinate Units: meters, Altitude: height above mean sea level (MSL) – meters.  2. Accuracy to Datum – 3.05 meters  3. Data Collection Method: Survey grade GPS: Post Processed Differential	
Real-Time Differential	
Mapping Grade GPS X : Post Pr	
Real-Time Differential X	
4. Letter size copy of the topography map showing the well location.  I the undersigned, hereby certify this data is correct to the best of my knowledge and belief and shows all the information required by law and the regulations issued and prescribed by the Office of Oil and Gas.	
Extrees (	Construction Specialist I 2 2 0 13 Date
Signature	Title Date

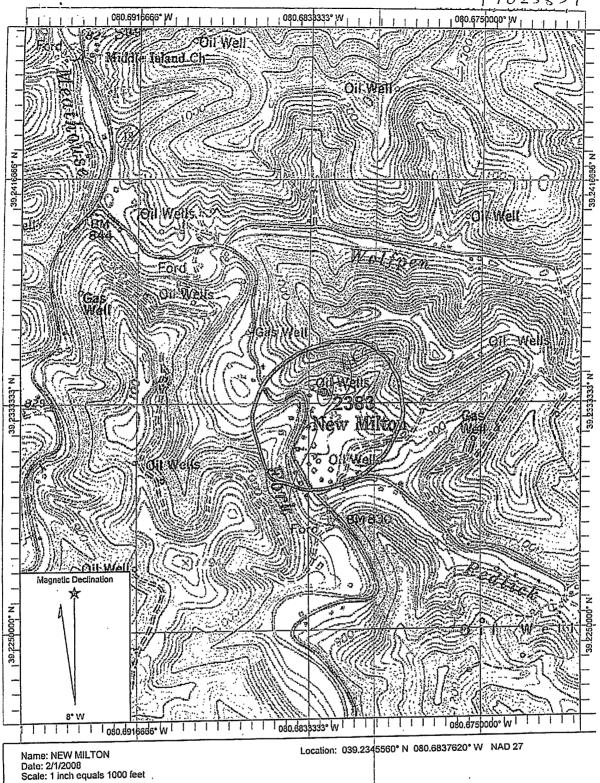

Copyright (C) 1997, Maptech, Inc.