

Minimum Error of Closure 1' IN 200'
 Source of Elevation ROAD FORK - BUCKEYE RUN - ELEVATION 873'
 "I, the undersigned, hereby certify that this map is correct to the best of my knowledge and belief and shows all the information required by paragraph 6 of the rules and regulations of the oil and gas section of the mining laws of West Virginia."

- FRACTURE...
- New Location...
- Drill Deeper...
- Abandonment...

MAP SHT. 54, SQ. 511-W4; F.B. 1095 P.9

Company CONSOLIDATED GAS SUPPLY CORP.
 Address CLARKSBURG, WEST VA.
 Farm JACOB F. STUTTLE
 Tract _____ Acres 90 Lease No. 26520
 Well (Farm) No. _____ Serial No. 5622
 Elevation (Spirit Level) 1187'
 Quadrangle CENTERPOINT sw
 County DODDRIDGE District GRANT
 Engineer Jackson M. Jarvis
 Engineer's Registration No. 2397
 File No. _____ Drawing No. _____
 Date JAN. 21, 1969 Scale 1" = 600'

STATE OF WEST VIRGINIA
 DEPARTMENT OF MINES
 OIL AND GAS DIVISION
 CHARLESTON

WELL LOCATION MAP
 FILE NO. DOD-34-FRAC
2406

+ Denotes location of well on United States Topographic Maps, scale 1 to 62,500, latitude and longitude lines being represented by border lines as shown.
 - Denotes one inch spaces on border line of original tracing.



STATE OF WEST VIRGINIA
DEPARTMENT OF MINES
OIL AND GAS DIVISION

Rotary
Spudder
Cable Tools
Storage
Oil or Gas Well **Gas**
(KIND)

Quadrangle CENTERPOINT 4-35

Permit No. None DOD-34-FRAC

WELL RECORD

Company Consolidated Gas Supply Corporation
Address Clarksburg, W. Va.
Farm Jacob F. Stuttler Acres 90
Location (waters) _____
Well No. 5622 Elev. 1187'
District Grant County Doddridge
The surface of tract is owned in fee by _____
Address _____
Mineral rights are owned by _____
Address _____
Drilling commenced 8-11-19
Drilling completed 12-11-19
Date Shot 2-12-19 From INJUN To _____
With 75 Qts

Casing and Tubing	Used in Drilling	Left in Well	Packers
Size			Kind of Packer
16			
13			
10	400	None	Size of
8 1/4	1151	1151	
6 3/4	1965	1965	Depth set
5 3/16	1979	1979	
4 1/2			
3			Perf. top
2	2123	None	Perf. bottom
Liners Used			Perf. top
			Perf. bottom

Open Flow _____ /10ths Water in _____ Inch
_____ /10ths Merc. in _____ Inch
Volume Old well Will frac Cu. Ft.
Rock Pressure Not taken lbs. hrs.
Oil None bbls., 1st 24 hrs.
WELL ACIDIZED (DETAILS) No
WELL FRACTURED (DETAILS) No

Attach copy of cementing record.
CASING CEMENTED _____ SIZE _____ No. Ft. _____ Date _____
Amount of cement used (bags) No cementing
Name of Service Co. _____
COAL WAS ENCOUNTERED AT 625 FEET 8 1/2 INCHES
FEET INCHES FEET INCHES
FEET INCHES FEET INCHES

RESULT AFTER TREATMENT (Initial open Flow or bbls.)


919 MCFGPD

ROCK PRESSURE AFTER TREATMENT 360# HOURS 64

Fresh Water 115 & 200' Feet Salt Water None Feet

Producing Sand Injun Will frac to increase production Depth See log

Formation	Color	Hard or Soft	Top	Bottom	Oil, Gas or Water	Depth	Remarks
Pittsburgh Coal			625	632	Water	115 & 200'	
Dunkard Sand			1140	1182			
Salt Sand			1375	1760			
Maxton Sand			1805	1850	Gas	1843'	
Injun Sand			1997	2113	Gas	2050'	
Serea Sand			2175	2183			
Santz Sand			2250	2370			
Stray Sand			2645	2648			
Gordon Sand			2700	2712			
Total Depth Drilled				2717'	TD		
Plugged back in 1919 to				2111	Present Total Depth		

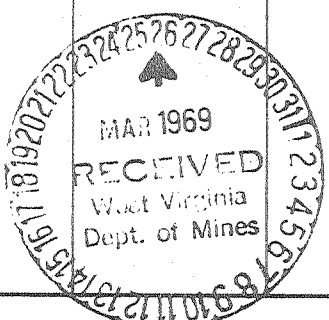

Consolidated Gas Supply Corporation
445 West Main Street
Clarksburg, W. Va.

OWWO; No new footage drld

OCT 27 1969

Well 5622
Permit DOD-34-FRAC
Farm Jacob F. Stutler
District Grant
County Doddridge
CP 4-35

G. NOLL

Mr. Robert L. Dodd, Deputy Director
State of West Virginia
Department of Mines
Oil and Gas Division
Charleston, West Virginia 25301

Dear Sir:

The following information on the completion of the above mentioned well should be added to the completion report (Form OG-10) already on file in your office:

Ran 2041 feet of 4 1/2" casing. Perforated from -----
to ----- with --- holes and fractured 4-30-69 with
500 bbl. water, 35,000 # Sand, 500 Gal. Acid and 2500HHP
4 1/2" Csg. cemented with 25 bags Open Hole Frac

The final open flow was 919,000M 919 M cubic feet and the rock pressure was 360# pounds in 64 ~~days~~ hours.

Very truly yours,
R. L. Payne
Manager of Production

