

WW-7
8-30-06



West Virginia Department of Environmental Protection
Office of Oil and Gas
WELL LOCATION FORM: GPS

47-017-02421

API: ~~47-017-02124~~ WELL NO.: WV 121441 (Longacre 2 A)

FARM NAME: Longacre

RESPONSIBLE PARTY NAME: EQT Production Company

COUNTY: Doddridge DISTRICT: West Union

QUADRANGLE: West Union 7.5'

SURFACE OWNER: Franklin L. Butler and Key Oil Company

ROYALTY OWNER: Lewis Maxwell Heirs, et al.

UTM GPS NORTHING: 4349280

UTM GPS EASTING: 521198 GPS ELEVATION: 321 m (1054 ft)

The Responsible Party named above has chosen to submit GPS coordinates in lieu of preparing a new well location plat for a plugging permit or assigned API number on the above well. The Office of Oil and Gas will not accept GPS coordinates that do not meet the following requirements:

- Datum: NAD 1983, Zone: 17 North, Coordinate Units: meters, Altitude: height above mean sea level (MSL) – meters.
- Accuracy to Datum – 3.05 meters
- Data Collection Method:
Survey grade GPS _____ : Post Processed Differential _____
Real-Time Differential _____
Mapping Grade GPS X : Post Processed Differential X
Real-Time Differential _____

Received
Office of Oil & Gas
JAN 16 2015

4. Letter size copy of the topography map showing the well location.

I the undersigned, hereby certify this data is correct to the best of my knowledge and belief and shows all the information required by law and the regulations issued and prescribed by the Office of Oil and Gas.

Steve Brown
Signature

PS #2180
Title

12/11/14
Date

Topo Quad: West Union 7.5'

Scale: 1" = 2000'

County: Doddridge


Date: November 03, 2014

District: West Union

Project No: 67-30-00-08

47-017-02124 WV 121441 (Longacre 2 A)

Topo

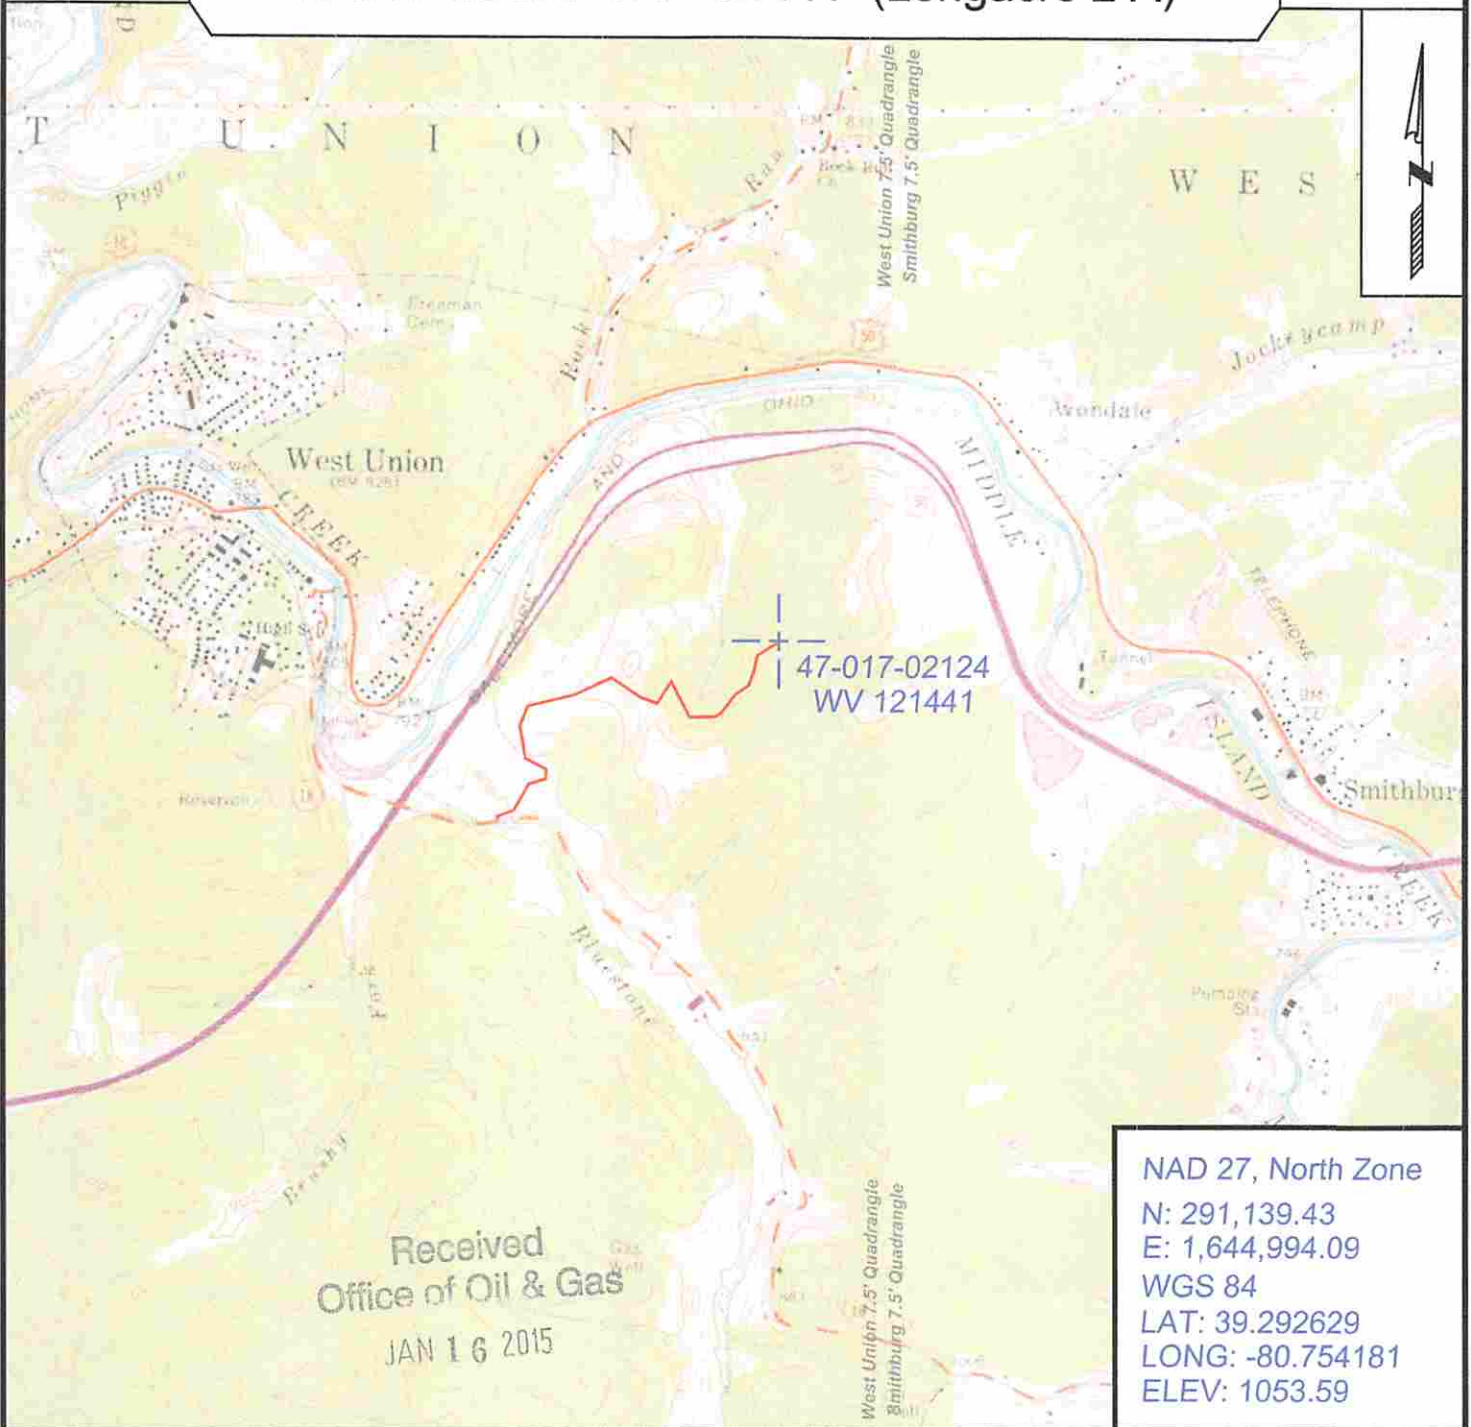

Received
Office of Oil & Gas
JAN 16 2015

NAD 27, North Zone
N: 291,139.43
E: 1,644,994.09
WGS 84
LAT: 39.292629
LONG: -80.754181
ELEV: 1053.59



SURVEYING AND MAPPING SERVICES PERFORMED BY:

ALLEGHENY SURVEYS, INC.

1-800-482-8606
237 Birch River Road
Birch River, WV 26610
PH: (304) 649-8606
FAX: (304) 649-8608

PREPARED FOR:

EQT Production Company

P.O. Box 280
Bridgeport, WV 26330