

WW-7  
8-30-06



West Virginia Department of Environmental Protection  
Office of Oil and Gas

**WELL LOCATION FORM: GPS**

API: 47-017-02631 WELL NO.: 6

FARM NAME: Cunningham

RESPONSIBLE PARTY NAME: Diversified Production LLC

COUNTY: Doddridge DISTRICT: Central

QUADRANGLE: Oxford

SURFACE OWNER: Elaine James

ROYALTY OWNER: Smith & Smith Partnership etal

UTM GPS NORTHING: 4,341,814.2

UTM GPS EASTING: 513,058 GPS ELEVATION: 1147'

The Responsible Party named above has chosen to submit GPS coordinates in lieu of preparing a new well location plat for a plugging permit or assigned API number on the above well. The Office of Oil and Gas will not accept GPS coordinates that do not meet the following requirements:

1. Datum: NAD 1983, Zone: 17 North, Coordinate Units: meters, Altitude: height above mean sea level (MSL) – meters.
2. Accuracy to Datum – 3.05 meters
3. Data Collection Method:

Survey grade GPS \_\_\_\_: Post Processed Differential \_\_\_\_


Real-Time Differential \_\_\_\_

Mapping Grade GPS : Post Processed Differential


Real-Time Differential \_\_\_\_

4. Letter size copy of the topography map showing the well location.

I the undersigned, hereby certify this data is correct to the best of my knowledge and belief and shows all the information required by law and the regulations issued and prescribed by the Office of Oil and Gas.

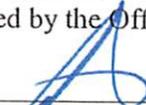 Director Production 08/12/2021  
Signature Title Date

09/24/2021

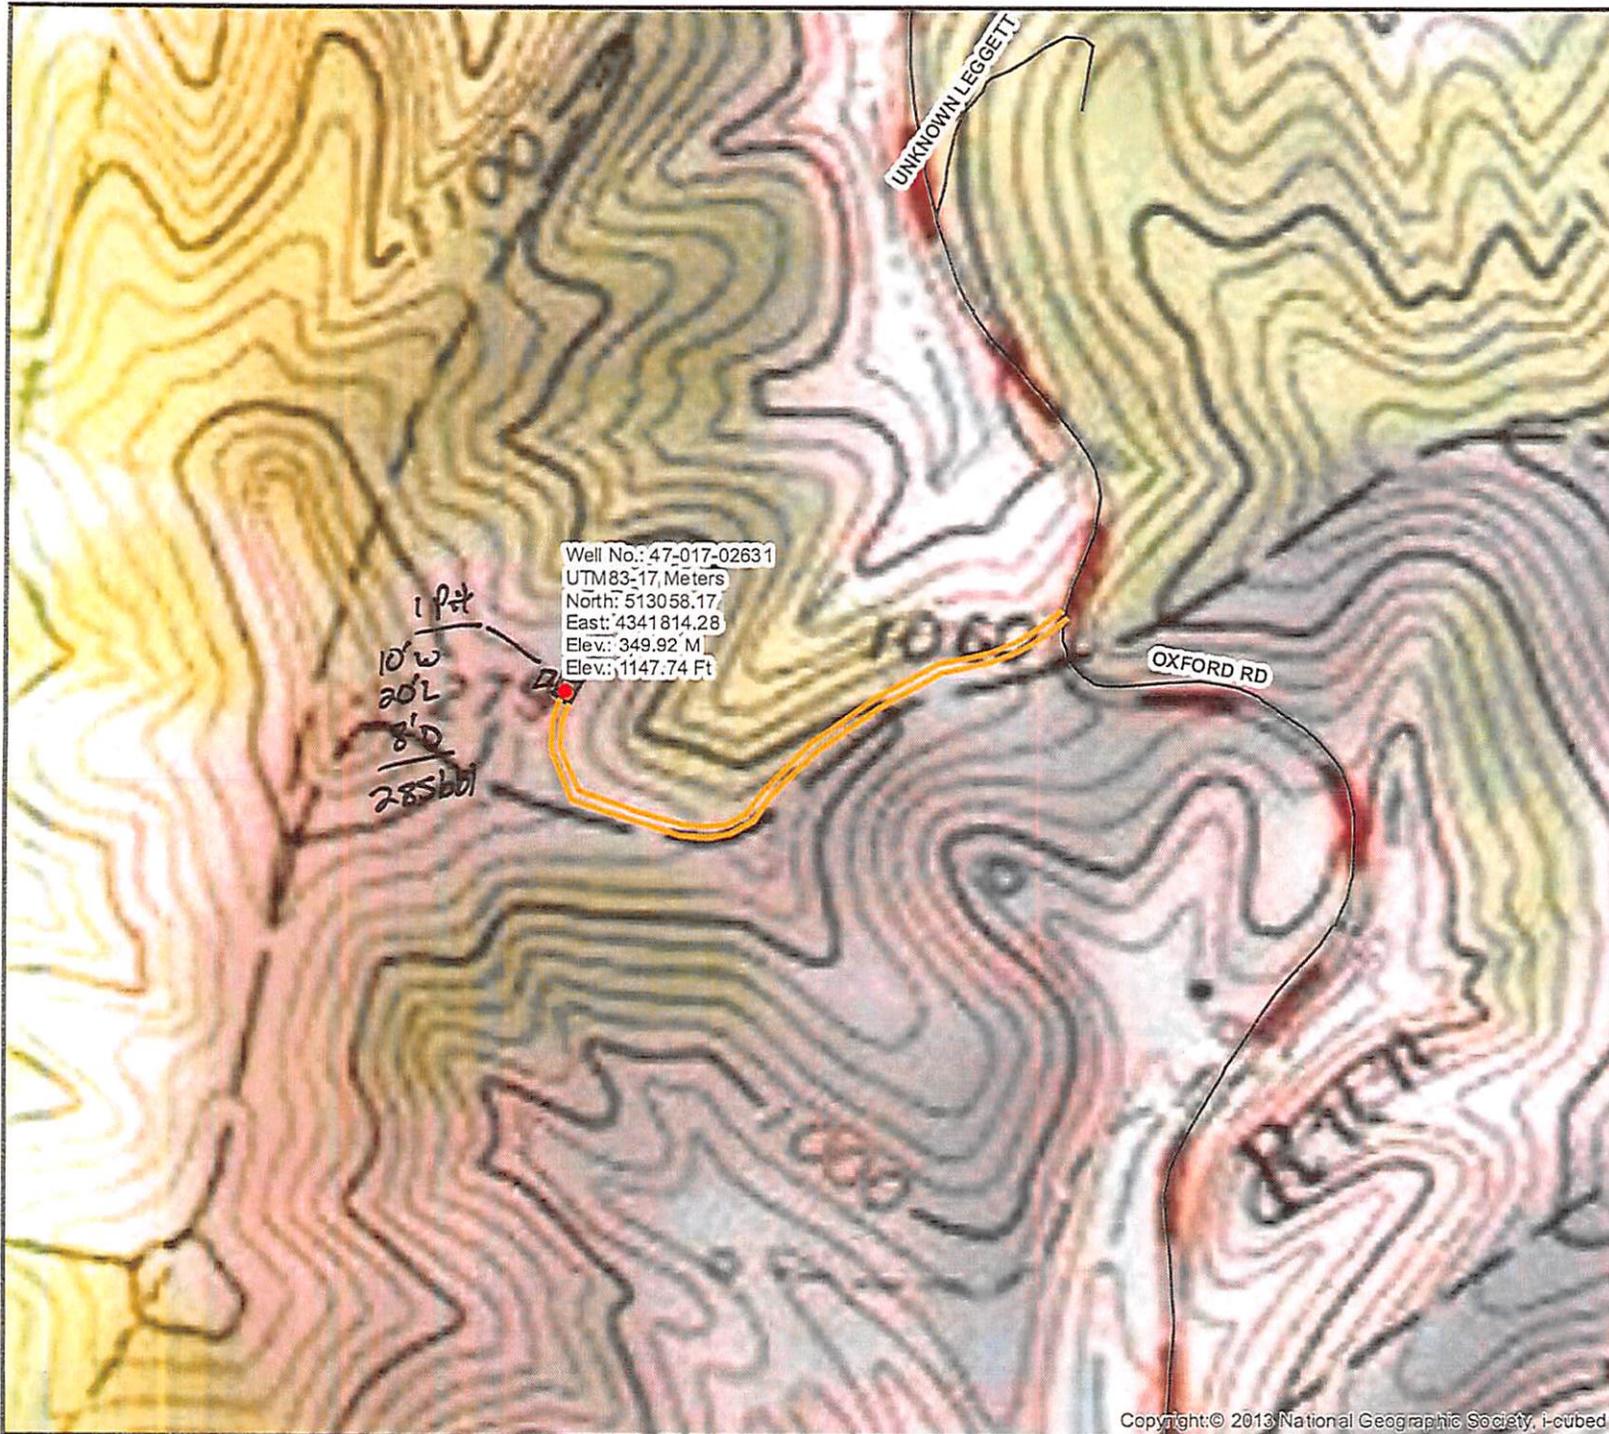



Diversified Gas & Oil  
Corporation  
100 Diversified Way  
Pikeville KY, 41051

47-017-02631

Plugging Map

**Legend**

- Well
- Access Road
- Pits
- Pad
- Public Roads

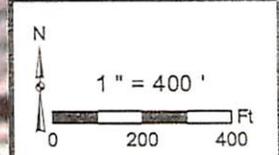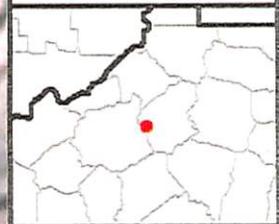

Copyright: © 2013 National Geographic Society, i-cubed

4701702631P