

WW-7
8-30-06



West Virginia Department of Environmental Protection
Office of Oil and Gas

WELL LOCATION FORM: GPS

API: 47-017-02859 WELL NO.: Ellifritt #1
FARM NAME: Antero Resources Corporation
RESPONSIBLE PARTY NAME: Jack D. McCune
COUNTY: Doddridge DISTRICT: Central
QUADRANGLE: Pennsboro
SURFACE OWNER: Antero Resources Corporation
ROYALTY OWNER: James R. Sandstrom
UTM GPS NORTHING: 4346720.157
UTM GPS EASTING: 509285.560 GPS ELEVATION: 1062'

The Responsible Party named above has chosen to submit GPS coordinates in lieu of preparing a new well location plat for a plugging permit or assigned API number on the above well. The Office of Oil and Gas will not accept GPS coordinates that do not meet the following requirements:

1. Datum: NAD 1983, Zone: 17 North, Coordinate Units: meters, Altitude: height above mean sea level (MSL) – meters.
2. Accuracy to Datum – 3.05 meters
3. Data Collection Method:
Survey grade GPS : Post Processed Differential
Real-Time Differential
Mapping Grade GPS : Post Processed Differential
Real-Time Differential

4. Letter size copy of the topography map showing the well location.

I the undersigned, hereby certify this data is correct to the best of my knowledge and belief and shows all the information required by law and the regulations issued and prescribed by the Office of Oil and Gas.

Jack D. McCune
Signature


Title

6/16/2015

Date

07/03/2015

17-2859

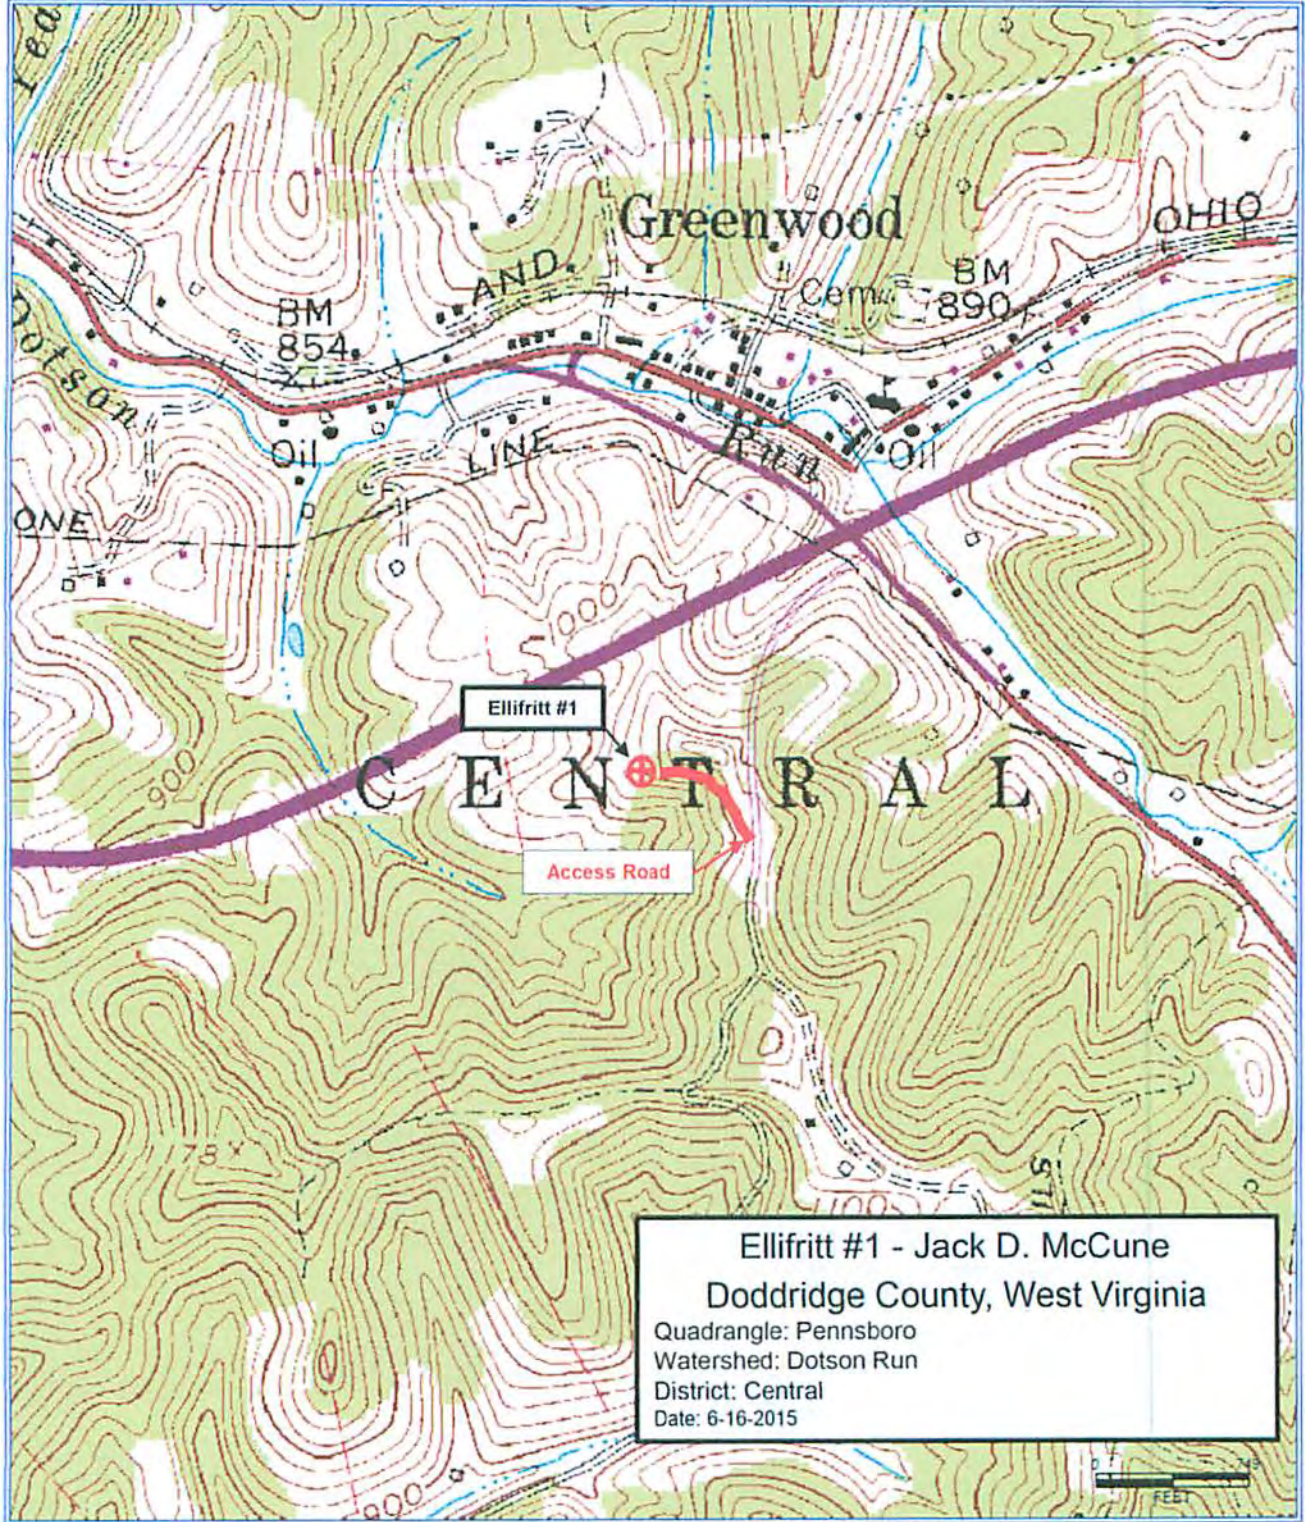

Ellifritt #1 - Jack D. McCune
Doddridge County, West Virginia
Quadrangle: Pennsboro
Watershed: Dotson Run
District: Central
Date: 6-16-2015