

1703231P

WW-7
5-02



West Virginia Department of Environmental Protection
Office of Oil and Gas
WELL LOCATION FORM: GPS

API: 47-017-03231 WELL NO.: 10106

FARM NAME: E. S. GIBSON

RESPONSIBLE PARTY NAME: CNX GAS COMPANY LLC

COUNTY: DODDRIDGE DISTRICT: GREENBRIER

QUADRANGLE: SALEM 7.5 MIN.

SURFACE OWNER: DENISE A. FEELEY 4027 GREYSTONE DR., MORGANTOWN, WV 26508

ROYALTY OWNER: RUBY HOSKINSON, ET. AL.


UTM GPS NORTHING: 4,346,487.95 METERS

UTM GPS EASTING: 532,809.84 METERS GPS ELEVATION: 298.75 METERS 980.16 FT

The Responsible Party named above has chosen to submit GPS coordinates in lieu of preparing a new well location plat for a plugging permit on the above well. The Office of Oil and Gas will not accept GPS coordinates that do not meet the following requirements:

1. Datum: NAD 1983, Zone: 17 Coordinate Units: meters Altitude: Height above mean sea level (MSL) - meters
2. Accuracy to Datum - 3.05 meters
3. Data Collection Method: Survey Grade GPS : Post Processed Differential Real-Time Differential
Mapping Grade GPS : Post Processed Differential Real-Time Differential

I the undersigned hereby state this data is correct to the best of my knowledge and belief and shows all the information required by law and the regulation issued and prescribed by the Office of Oil and Gas.

Signature 
Stephen D. Losh, PS #674

Title WV Professional Surveyor #674
Office of Oil and Gas
WV Dept. of Environmental Protection


Date 05/20/13

Received
OCT 18 2013



CNX USE: NAD 27 WV NORTH SPC: 10106 = 281,342.40' 1,682,945.52' ELEV. = 980.16'

1703231P

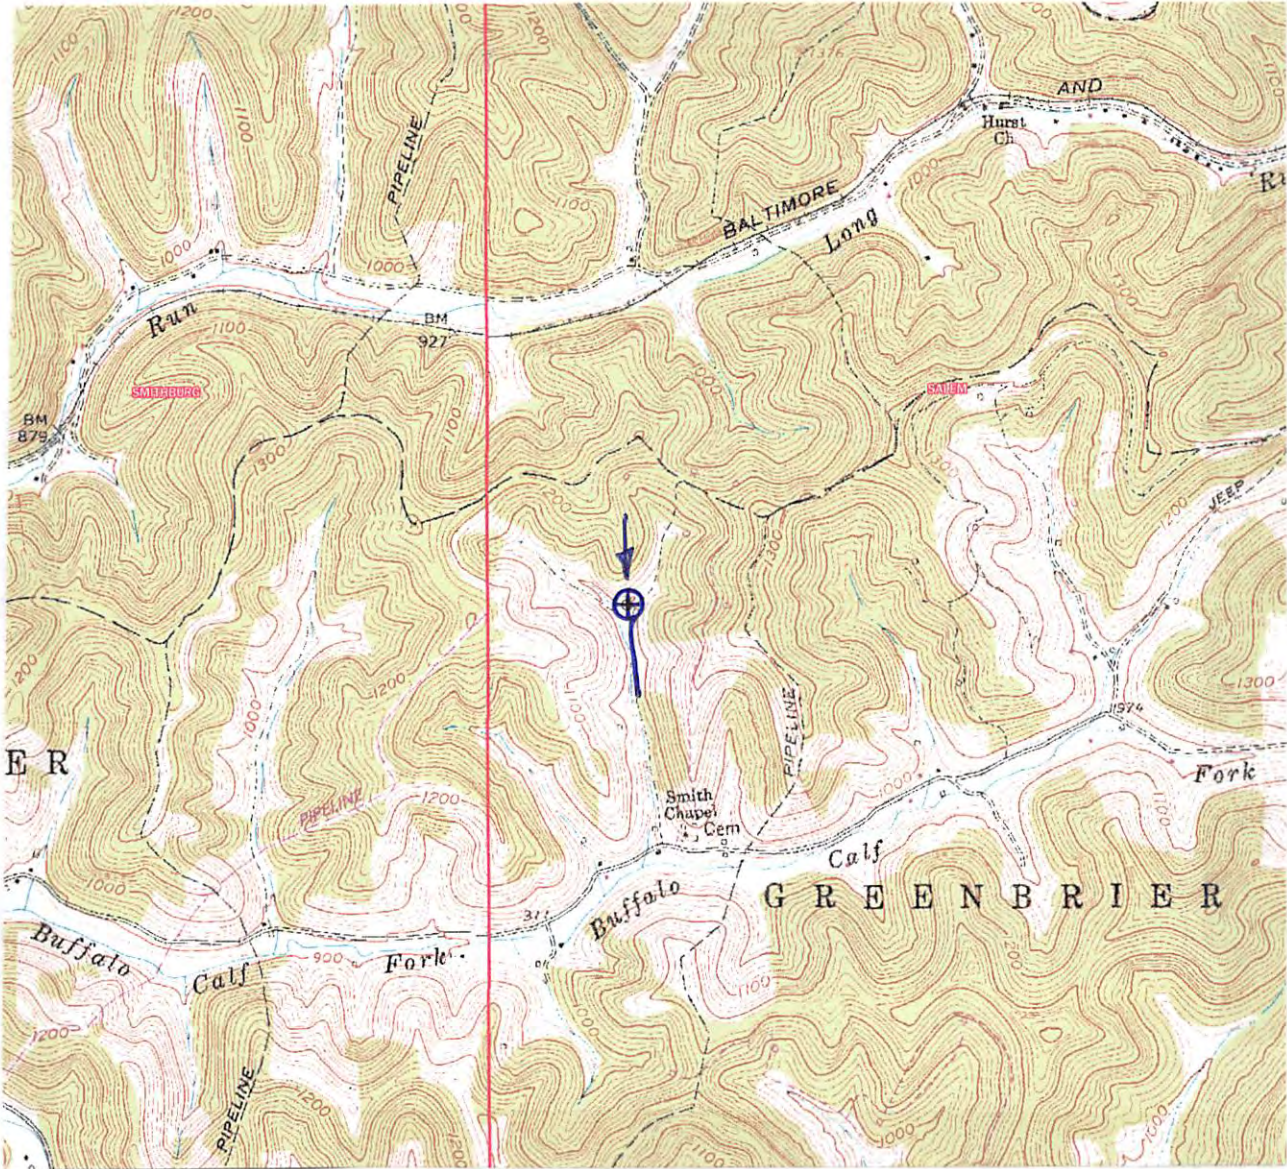

DRAWINGS TO ACCOMPANY FORM WW-9

CNX GAS COMPANY LLC

P. O. BOX 1248

JANE LEW, WV 26378

WATERSHED: BUFFALO Calf FORK

DISTRICT: GREENBRIER COUNTY: DODDRIDGE

QUADRANGLE: SALEM WELL NO.: 10106

DATE: 05/20/13 PAGE of

Received

OCT 18 2013

Office of Oil and Gas
Environmental Protection

LAND SURVEYING SERVICES
21 CEDAR LANE
BRIDGEPORT, WV 26330
PHONE: 304-842-2018 OR 5762