


87B 7/3/87

5,800' LATITUDE 39°17'30" LONGITUDE 80° 45'

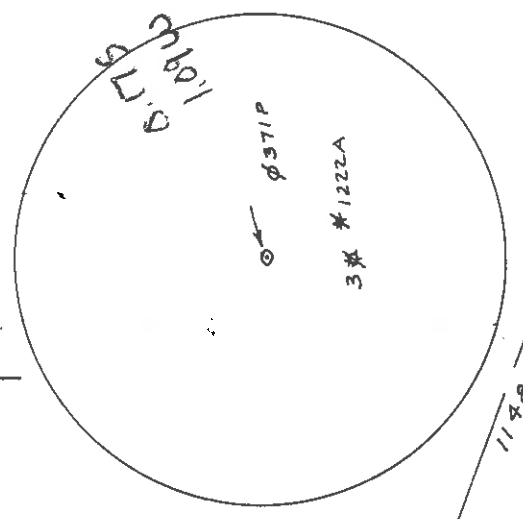

USGS ELEV. MARKER IN BRIDGE ABUTMENT

0.9 AC. TOWN OF W. UNION

569-39E

RAILROAD

BOARD OF EDUCATION 10.27 AC. T.M. 11-77

BLOCK FIELD HOUSE

N27-23E 179.5' N46-48E 154.9'

EXISTING WELL

NORTH

BRIDGE

END OF SOUTHWEST ABUTMENT


886.3'

CC 22 E 2 E X

MIDDLE E

FILE NO. 87-34
DRAWING NO. 1
SCALE 1" = 200'
MINIMUM DEGREE OF ACCURACY 1/2500
PROVEN SOURCE OF ELEVATION BM. 805

I THE UNDERSIGNED, HEREBY CERTIFY THAT THIS PLAT IS CORRECT TO THE BEST OF MY KNOWLEDGE AND BELIEF AND SHOWS ALL THE INFORMATION REQUIRED BY LAW AND THE REGULATIONS ISSUED AND PRESCRIBED BY THE DEPARTMENT OF MINES.
(SIGNED) Neal Hughes
R.P.E. L.I.S. 632

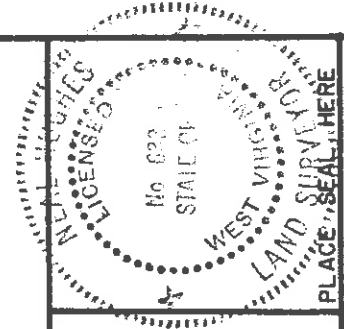

(+) DENOTES LOCATION OF WELL ON UNITED STATES TOPOGRAPHIC MAPS
FORM IV-6 (8-78)



Department of Mines
Oil & Gas Division

DATE July 13 19 87
OPERATOR'S WELL NO. L.T. DAVIS
API WELL NO. 47-017-3571X
STATE COUNTY PERMIT

WELL TYPE: OIL GAS LIQUID INJECTION WASTE DISPOSAL
(IF "GAS", PRODUCTION STORAGE DEEP SHALLOW
LOCATION: ELEVATION 778' WATER SHED MIDDLE ISLAND CREEK
DISTRICT WEST UNION COUNTY DODDRIDGE
QUADRANGLE WEST UNION 7 1/2'
SURFACE OWNER BOARD OF EDUCATION ACREAGE 10.27
OIL & GAS ROYALTY OWNER L.T. DAVIS HRS. LEASE ACREAGE 10.27

PROPOSED WORK: DRILL CONVERT DRILL DEEPER REDRILL FRACTURE OR STIMULATE PLUG OFF OLD FORMATION PERFORATE NEW FORMATION OTHER PHYSICAL CHANGE IN WELL (SPECIFY) _____

PLUG AND ABANDON CLEAN OUT AND REPLUG _____
TARGET FORMATION _____ ESTIMATED DEPTH 2348'
WELL OPERATOR EMPIRE OIL CO. DESIGNATED AGENT P.D. FARR II
ADDRESS PO BOX 307 ADDRESS PO BOX 307
WEST UNION, WV 26456 WEST UNION, WV 26456

AUG 10 1987

ALLEN BLUEPRINT Co.

Charleston, WV

MAY 17, 90

Division of Energy
Oil and Gas Section

AFFIDAVIT OF PLUGGING AND FILLING WELL

AFFIDAVIT SHOULD BE MADE IN TRIPLICATE, one copy mailed to the Division, one copy to the Well Operator and the third copy (and extra copies if required) should be mailed to each coal operator at their respective addresses.

Carlyn E. FARR Name of Well Operator
Coal Operator or Owner EMPIRE OIL CO.
WEST UNION, W. VA. 26456 Complete Address
Address
J. D. Foley HEIR'S 19
Coal Operator or Owner
WEST UNION, W. VA. 26456 WELL AND LOCATION
Address
DODDRIDGE County
Lease or Property Owner
WEST UNION, W. VA. 26456 WELL NO. 47-017-3577-P.
Address Farm

STATE INSPECTOR SUPERVISING PLUGGING Mike Yumbulov
AFFIDAVIT

STATE OF WEST VIRGINIA, ss:
County of Doddridge and P.O. FARR, II

N. A. FARR being first duly sworn according to law depose and say that they are experienced in the work of plugging and filling oil and gas wells and were employed by EMPIRE OIL CO., well operator, and participated in the work of plugging and filling the above well, that said work was commenced on the 20 day of Aug., 19 87, and that the well was plugged and filled in the following manner:

Sand or Zone Record Formation	Filling Material	Plugs Used Size & Kind	Casing	
			CSG PULLED	CSG LEFT IN
FROM MY RECORDS, IN MY HAND BOOK RAN-IN- Hole with 1 1/2 THUBBING TO 2264'	GELLED HOLE TO SURFACE	14-3-BARRELS of GEL - 3-5K5-		
PULLED 1 1/2 up THREE JOINTS	SETH 22.7-5K5	4-8-BARRELS of CEMENT.		
PULLED 1 1/2 up NINE JOINTS	SETH 22.7-5K5	4-8-BARREL of CEMENT.		
PULLED 1 1/2 up THREE JOINTS.	GELLED	6.0 BARREL TO SURFACE AGAIN.		
RIPPED 1 1/2 out of Hole				
RAN IN HOLE WITH WIRE LINE	Shot off 650'S AT 1000'	(COULD NOT PULL)		
RAN-BACK IN HOLE WITH WIRE LINE	Shot off SECOND TIME	BOO-COULD NOT PULL--		
RAN-BACK 1000' OR 1020' -- NOT SUCCESSFUL	SETH 17-5K5 - AT 1000'	CEMENT.		
PULLED up 1 1/2 4-Joints	SETH 13.8-9K5	CEMENT.		
PULLED up 1 1/2 22-Joints	SETH 14-4-5K5	CEMENT.		
PULLED up 1 1/2 16 Joints	SETH SURFACE PLUG.	CEMENT.		
Coal Seams		Description of Monument		
(Name)		Placed Metal with A.P.I. No.		
(Name)		IN TOP of CEMENT Below Surface		
(Name)		AT End zone of FOOTBALL FIELD		
(Name)		By Request of SURFACE OWNER.		

and that the work of plugging and filling said well was completed on the ___ day of Aug, 19 87.
And further deponents saith not.

Sworn to and subscribed before me this ___ day of ___, 19 ___,
Notary Public

My commission expires: _____
Permit No. 017-3577-P

MAY 20 1990