

INSTRUCTIONS

3920

204730

- 1) Attach a photo copy of the location of the well on a 7.5 minute Quadrangle with the corresponding Longitude and Latitude.
- 2) Designate the location of the well with the symbol (+).

2.75  
2.22

→ 7.5' loc  
12/9/20/91

I, the undersigned, hereby certify that this plat is correct to the best of my knowledge and belief.

SIGNED C E Hartman  
TITLE Field Foreman

DATE 5/30, 1990

OPERATORS WELL NO. Flanigan

API WELL NO. 017-3871

STATE OF WEST VIRGINIA  
DEPARTMENT OF ENERGY  
OIL AND GAS DIVISION

WELL TYPE: OIL X GAS \_\_\_\_\_ LIQUID INJECTION \_\_\_\_\_ WASTE DISPOSAL \_\_\_\_\_  
(IE "GAS" PRODUCTION \_\_\_\_\_ STORAGE \_\_\_\_\_ DEEP \_\_\_\_\_ SHALLOW \_\_\_\_\_)

LOCATION: ELEVATION \_\_\_\_\_ WATER SHED West Union  
DISTRICT Central COUNTY Doddridge  
QUADRANGLE West Union

SURFACE OWNER C E Hartman ACREAGE 19

OIL & GAS ROYALTY OWNER \_\_\_\_\_ LEASE ACREAGE \_\_\_\_\_  
LEASE NO. \_\_\_\_\_

PRODUCING FORMATION Big Engine TOTAL DEPTH 2,100

WELL OPERATOR Herman Siegel, Ltd DESIGNATED AGENT \_\_\_\_\_

ADDRESS 139 East McClellan Ave ADDRESS \_\_\_\_\_

Livingston, New Jersey 07039


Wood County wells. 4760

FEB 1 1991

11806

Latitude 39° 1730

Longitude 80° 5015

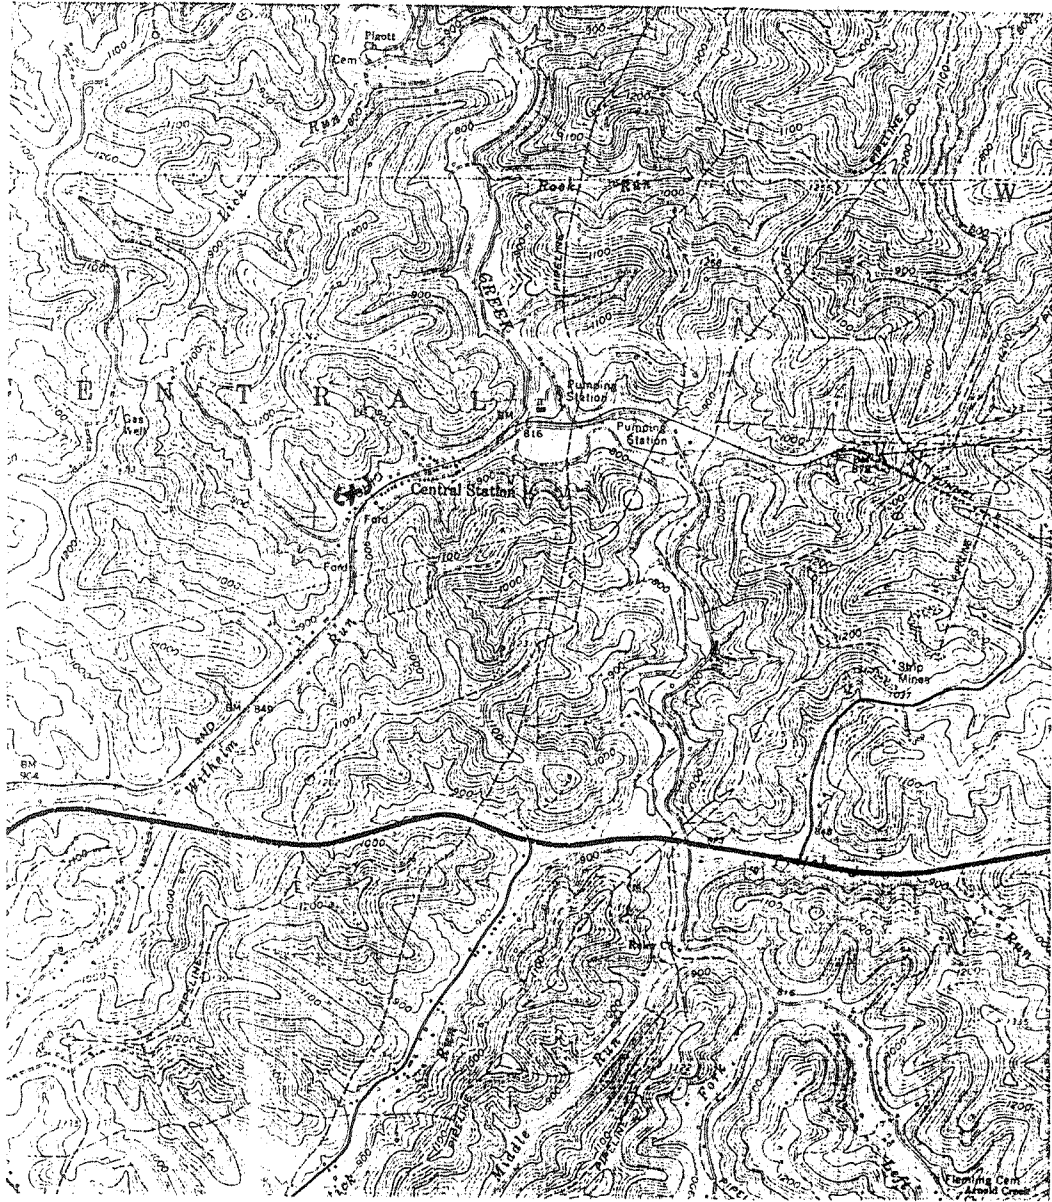

FLANNIGAN well

017-3871