

LATITUDE 39 1230

7.5' loc
Kla 9/20/91

0.15
1.24 0

80 50

LONGITUDE

7.5 @GIS topo location

7.5' loc _____

15' loc _____
(calc.) _____

Company _____

Farm _____


Quad Oxford

County _____

District Central

WELL LOCATION MAP

File No. 017 3872

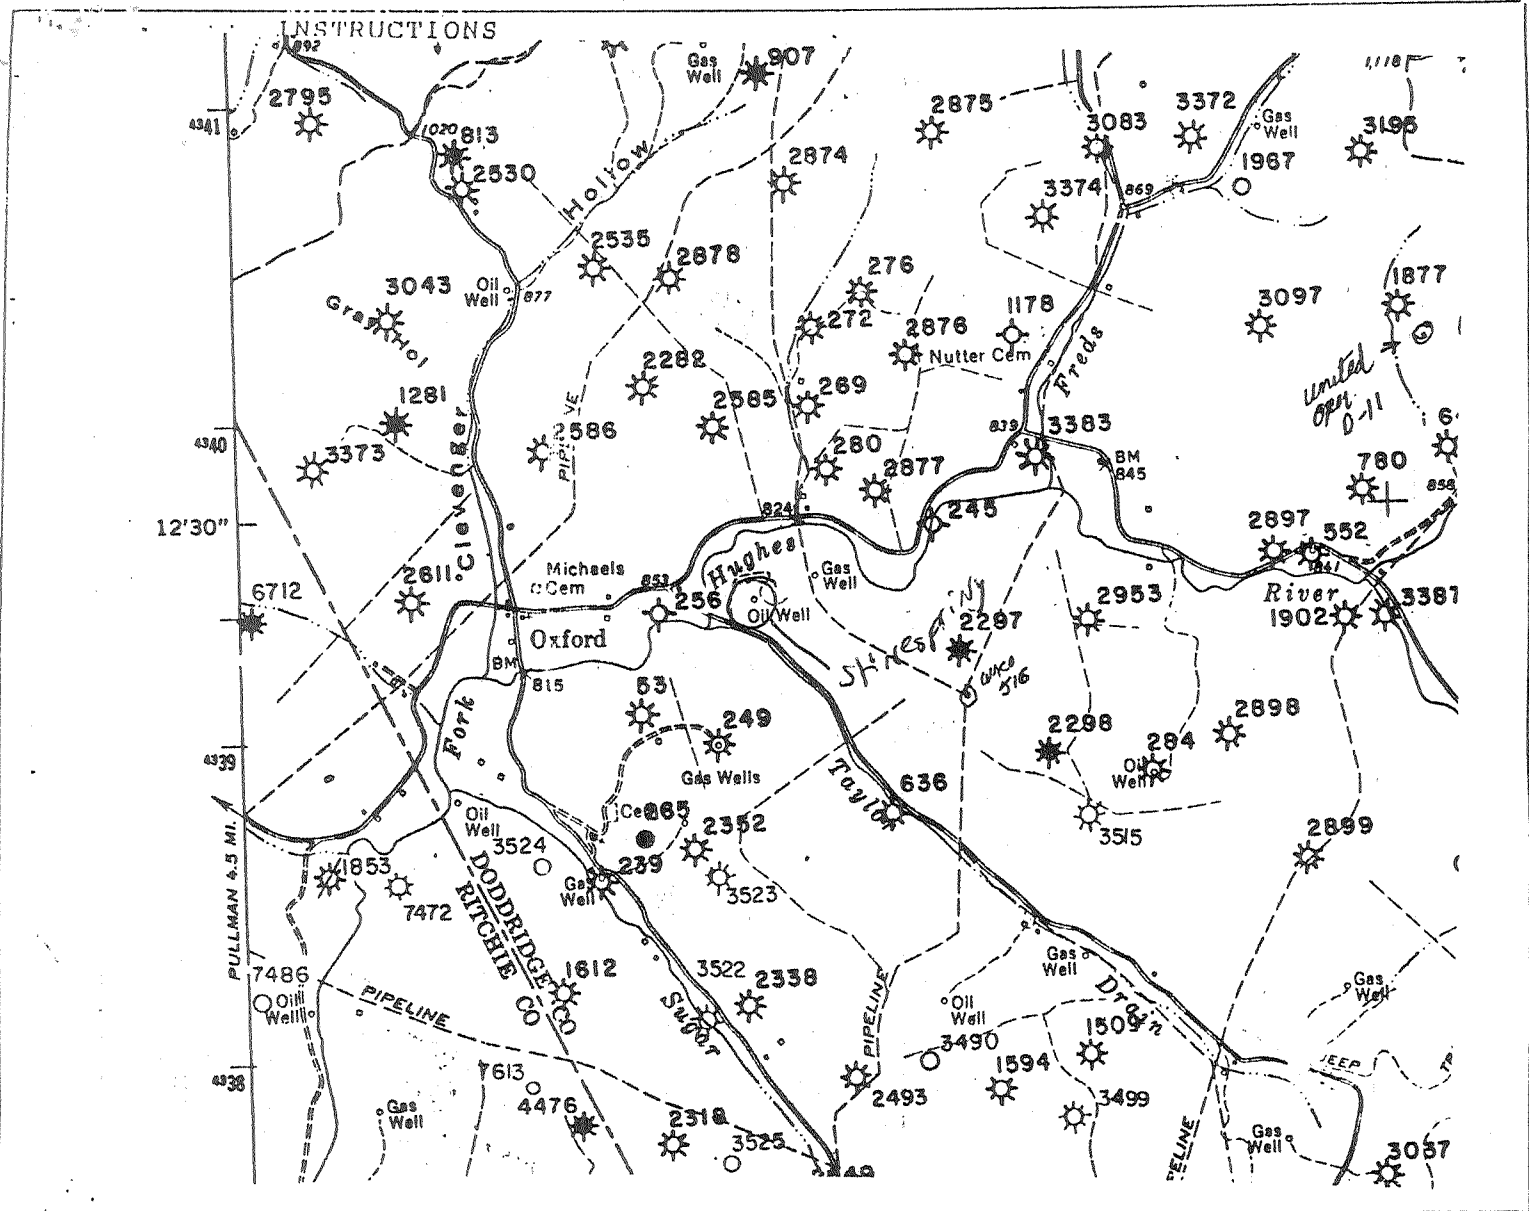

I, the undersigned, Hereby certify that this plat is correct to the best of my knowledge and belief.

SIGNED C E Nesler

TITLE Owner

DATE 5-23-90, 1990

OPERATORS WELL NO. STINESPRING #1

API WELL NO. 017-3872

STATE OF WEST VIRGINIA
DEPARTMENT OF ENERGY
OIL AND GAS DIVISION

WELL TYPE: OIL X GAS _____ LIQUID INJECTION _____ WASTE DISPOSAL _____
(ie "GAS" PRODUCTION _____ STORAGE _____ DEEP _____ SHALLOW _____)

LOCATION: ELEVATION _____ WATER SHED _____
DISTRICT Summers COUNTY Doddridge
QUADRANGLE OXFORD

SURFACE OWNER Judy Stine ACREAGE _____
OIL & GAS ROYALTY OWNER Mildred Maxwell LEASE ACREAGE _____
LEASE NO. _____

PRODUCING FORMATION _____ TOTAL DEPTH 1952

WELL OPERATOR C. E. Nesler DESIGNATED AGENT Same

ADDRESS P.O. Box 154 ADDRESS Same
West Union, WV 26456

11905