

INSTRUCTIONS


RECEIVED
Division of Energy

NOV 20 89

Oil and Gas

Longitude 80° 47' 30" (2050')

1) Attach a photo copy of the location of the well on a 7.5 minute Quadrangle with the corresponding Longitude and Latitude.
2) Designate the location of the well with the symbol(+).

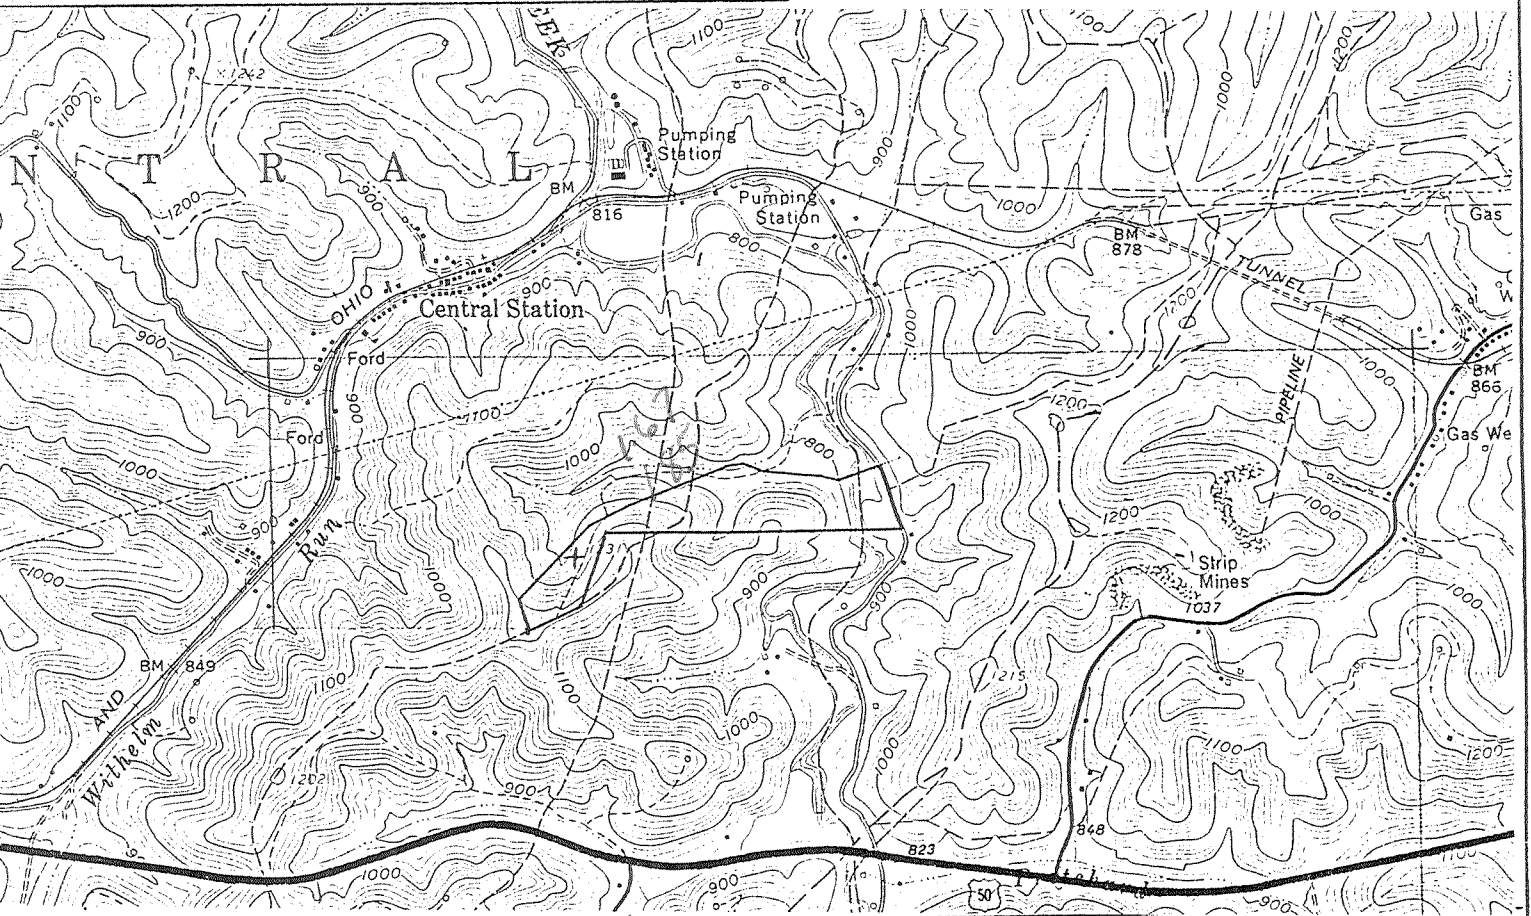

I, the undersigned, Hereby certify that this plat is correct to the best of my knowledge and belief.

455
4.08

SIGNED James J Shearer
TITLE President

DATE November 17, 1989
OPERATORS WELL NO. Wm. Rollins #1
API WELL NO. 017-3876

STATE OF WEST VIRGINIA
DEPARTMENT OF ENERGY
OIL AND GAS DIVISION

According to DEP checked 12-9-29

WELL TYPE: OIL GAS LIQUID INJECTION _____ WASTE DISPOSAL _____
(IF "GAS" PRODUCTION STORAGE _____ DEEP _____ SHALLOW

LOCATION: ELEVATION 1040' WATER SHED Arnold's Creek
DISTRICT Central COUNTY Doddridge
QUADRANGLE West Union, WV 7 1/2' 15

SURFACE OWNER Hope Land Development, Inc. ACREAGE ± 60.5 Ac.

OIL & GAS ROYALTY OWNER C. P. Hudson Heirs LEASE ACREAGE 244.6 Ac.
LEASE NO. _____

PRODUCING FORMATION unknown TOTAL DEPTH 2182'

WELL OPERATOR James Drilling Corporation 436 DESIGNATED AGENT _____

ADDRESS 436 Newport Road, P. O. Box 337 ADDRESS _____
Blairsville, PA 15717-0337

JAN 18 1991

INSTRUCTIONS

1) Attach a photo copy of the location of the well on a 7.5 minute Quadrangle with the corresponding longitude and Latitude.
 2) Designate the location of the well with the symbol(+).

0.30
1.67

RECEIVED


JAN 17 91

RECEIVED
Division of Energy

NOV 20 89

Oil and Gas

Longitude 80° 47' 30" (2050')

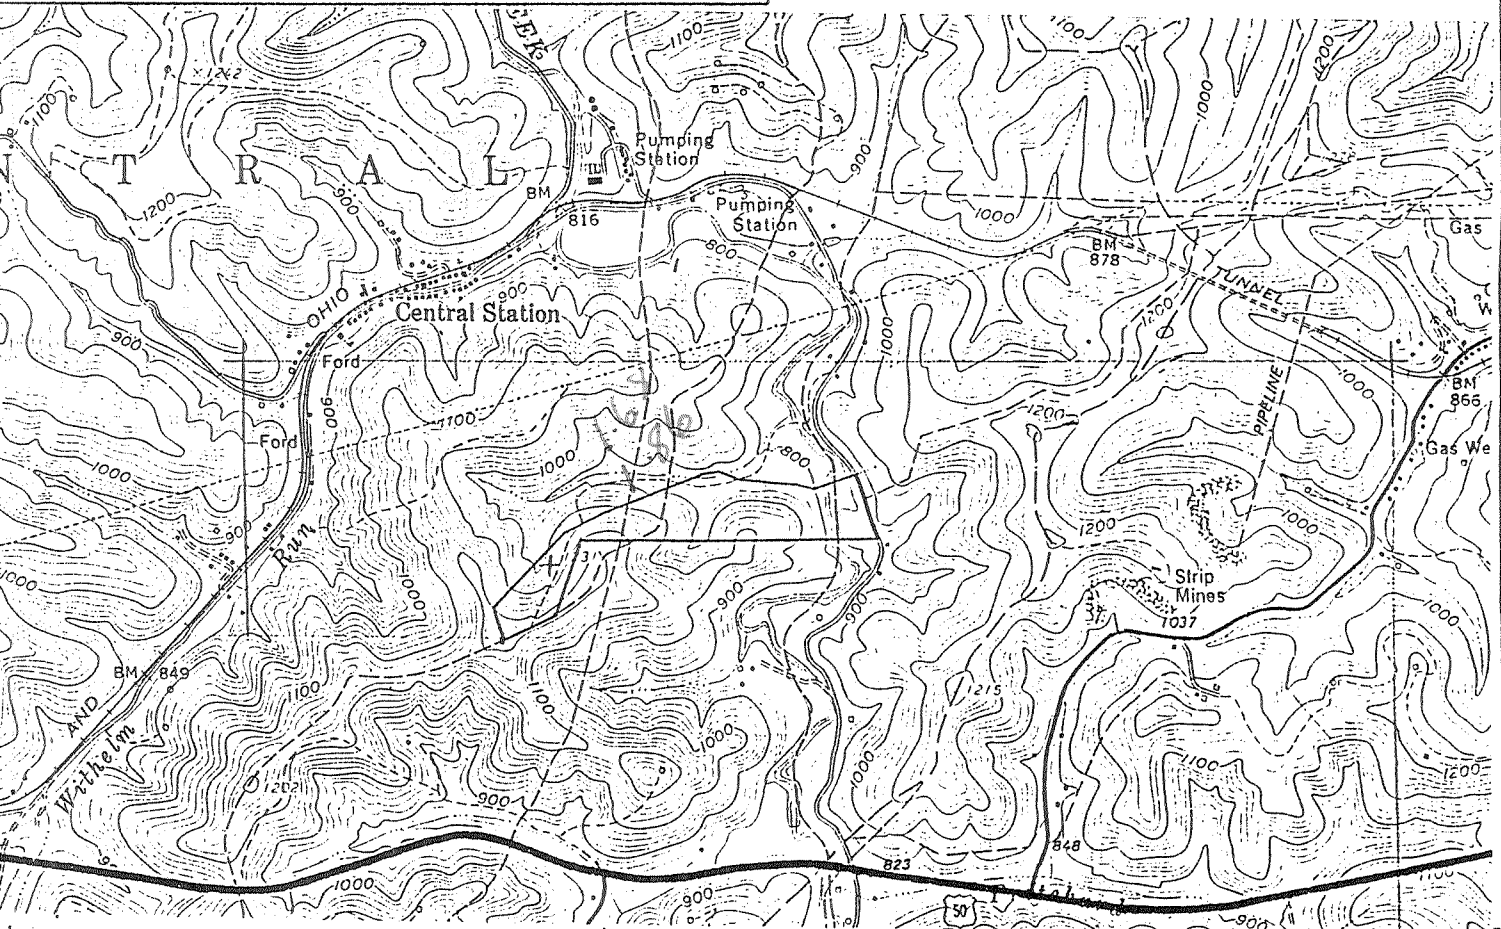

I, the undersigned, Hereby certify that this plat is correct to the best of my knowledge and belief.

SIGNED James J Shearer
TITLE President

455
408
West Union

DATE November 17, 1989
OPERATORS WELL NO. Wm. Rollins #1
API WELL NO. 017-3876

STATE OF WEST VIRGINIA
DEPARTMENT OF ENERGY
OIL AND GAS DIVISION

WELL TYPE: OIL GAS LIQUID INJECTION _____ WASTE DISPOSAL _____
"GAS" PRODUCTION _____ STORAGE _____ DEEP _____ SHALLOW

LOCATION: ELEVATION 1040' WATER SHED Arnold's Creek
DISTRICT Central COUNTY Doddridge
QUADRANGLE West Union, WV 7 1/2'

SURFACE OWNER Hope Land Development, Inc. ACREAGE ± 60.5 Ac.

OIL & GAS ROYALTY OWNER C. P. Hudson Heirs LEASE ACREAGE 244.6 Ac.
LEASE NO. _____

PRODUCING FORMATION unknown TOTAL DEPTH 2182'

WELL OPERATOR James Drilling Corporation DESIGNATED AGENT _____

ADDRESS 436 Newport Road, P. O. Box 337 ADDRESS _____
Blairsville, PA 15717-0337 436

FEB 1 1991