




INSTRUCTIONS

1) Attach a photo copy of the location of the well on a 7.5 minute Quadrangle with the corresponding Longitude and Latitude.  
 2) Designate the location of the well with the symbol (+).

39° 25' 30"

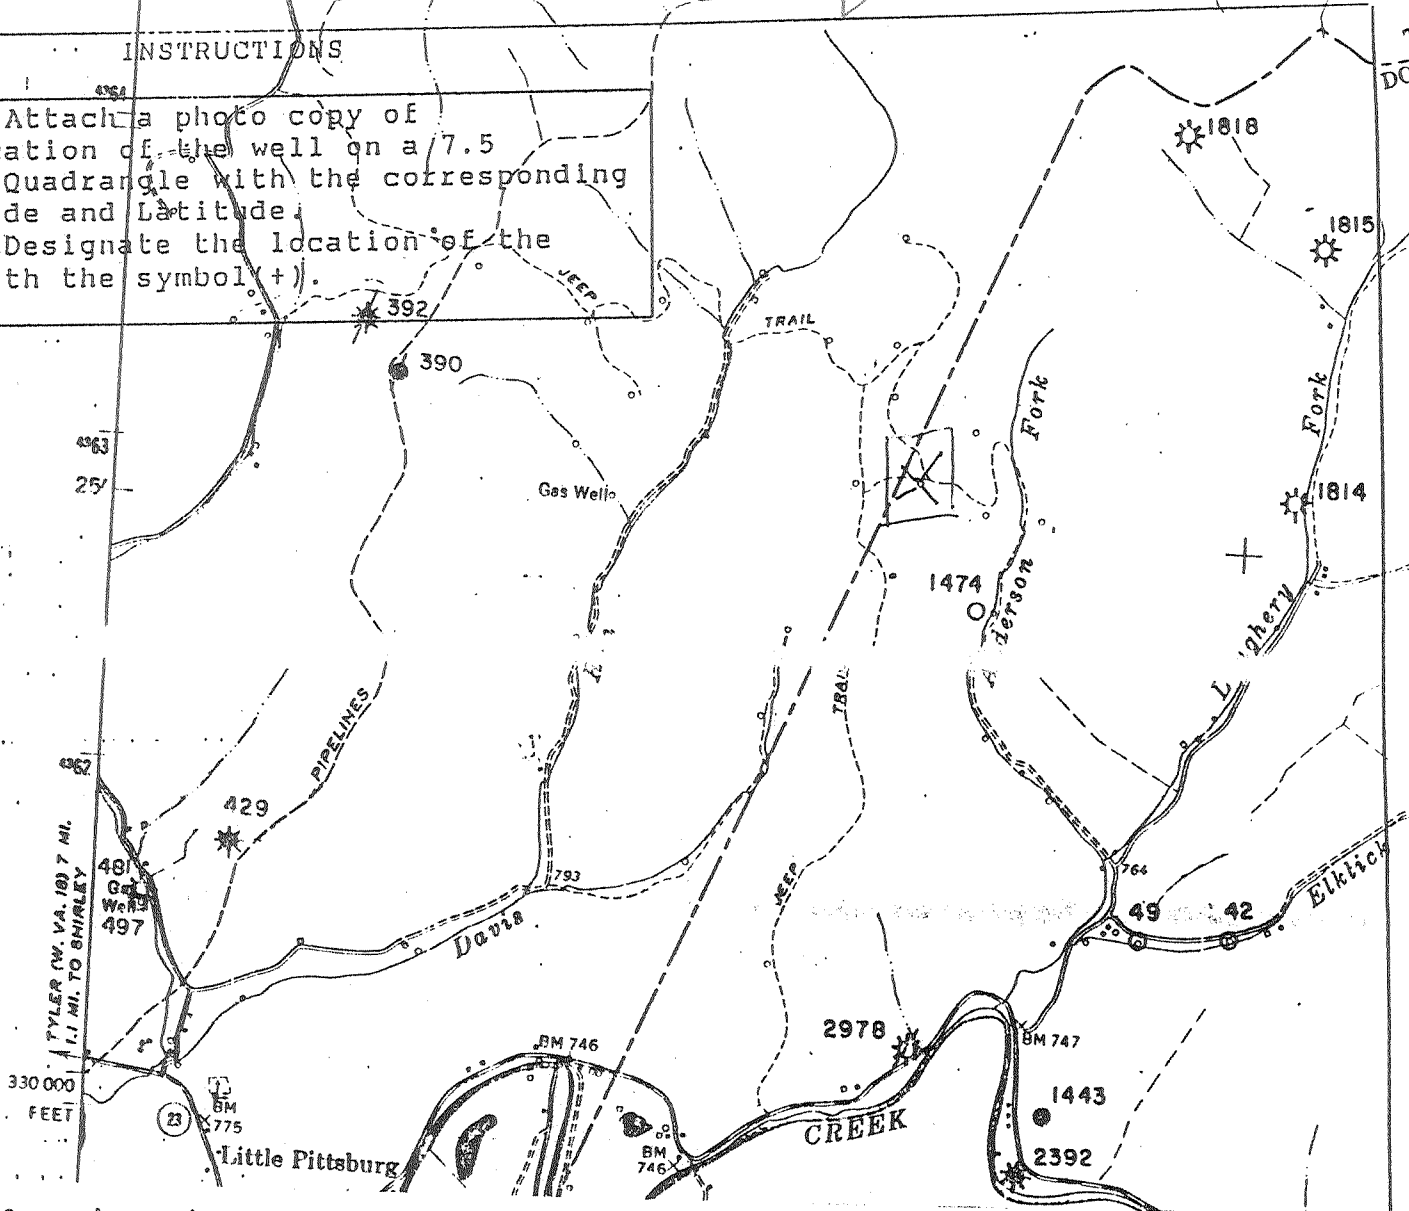

80°-42'-30"

I, the undersigned, Hereby certify that this plat is correct to the best of my knowledge and belief.

SIGNED Charles E. Anderson

TITLE VICE PRESIDENT

DATE AUGUST 21, 1990

OPERATORS WELL NO. 1

API WELL NO. 017-3925

STATE OF WEST VIRGINIA  
 DEPARTMENT OF ENERGY  
 OIL AND GAS DIVISION

WELL TYPE: OIL  GAS  LIQUID INJECTION  WASTE DISPOSAL   
 (IF "GAS" PRODUCTION  STORAGE  DEEP  SHALLOW

LOCATION: ELEVATION 1280 WATER SHED ANDERSON FORK  
 DISTRICT MCCELLEN COUNTY DODDRIDGE  
 QUADRANGLE CENTERPOINT

SURFACE OWNER UNKNOWN ACREAGE 50

OIL & GAS ROYALTY OWNER B.C. ANDERSON HEIRS LEASE ACREAGE 50  
 LEASE NO. 4

PRODUCING FORMATION BIG INJUN TOTAL DEPTH 2000

WELL OPERATOR DILMUR OIL COMPANY DESIGNATED AGENT CHARLES E. ANDERSON  
 ADDRESS CENTERPOINT STAR ROUTE BOX 165  
WEST UNION, W.Va. 26456 ADDRESS SAME

B. C. ANDERSON.

(4)