

✓ LATITUDE 39°17'30"

80 47 30

0 1.33
0.42

LONGITUDE

7'5 OGIS topo location

7.5' loc _____ 15' loc _____
(calc.) _____

Company _____

Farm _____


Quad _____

County _____

District _____

WELL LOCATION MAP

File No. 017 3928

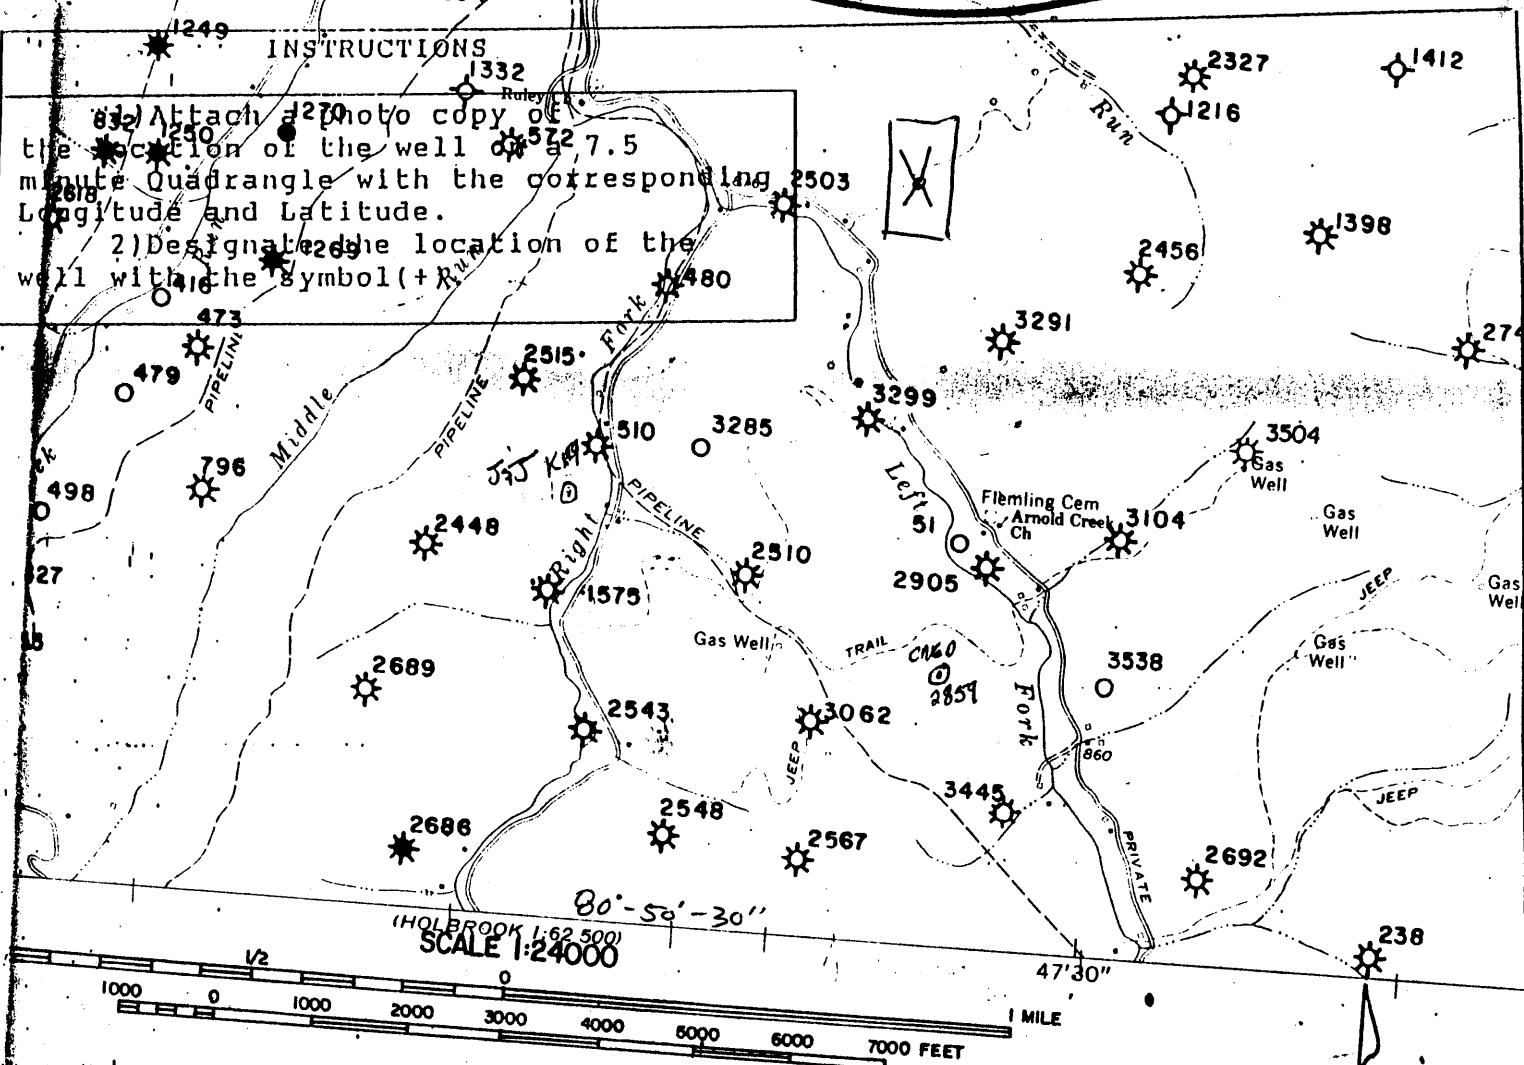

Well locations have been determined based upon information derived from surveyed well plats. Accuracy of well locations is relative to quality of available information.

map may not be reproduced without written consent of Oil & Gas Information Service, the undersigned, hereby certify that this plat is correct to the best of my knowledge and belief.

SIGNED Charles E. Anderson

TITLE VICE PRESIDENT

DATE AUGUST 21, 19 90

OPERATORS WELL NO. 1

API WELL NO. 017-3928

STATE OF WEST VIRGINIA
DEPARTMENT OF ENERGY
OIL AND GAS DIVISION

WELL TYPE: OIL X GAS _____ LIQUID INJECTION _____ WASTE DISPOSAL _____
(If "GAS" PRODUCTION _____ STORAGE _____ DEEP _____ SHALLOW _____)

LOCATION: ELEVATION 990 WATER SHED LEFT HAND FORK ARONLDS CREEK
DISTRICT WEST UNION COUNTY DODDRIDGE
QUADRANGLE WEST UNION

SURFACE OWNER EARL ROLLINS ACREAGE 40

OIL & GAS ROYALTY OWNER A.K. ROLLINS HEIRS LEASE ACREAGE 40
LEASE NO. 8

PRODUCING FORMATION BIG INJUN TOTAL DEPTH 2000

WELL OPERATOR DILMUR OIL COMPANY DESIGNATED AGENT CHARLES E. ANDERSON
CENTERPOINT STAR ROUTE BOX 165
ADDRESS WEST UNION, W.Va. 26456 ADDRESS SAME