


LATITUDE 39° 10' 00"
39° 12' 30"

INSTRUCTIONS

1) Attach a photo copy of the location of the well on a 7.5 minute Quadrangle with the corresponding Longitude and Latitude.

2) Designate the location of the well with the symbol (+).

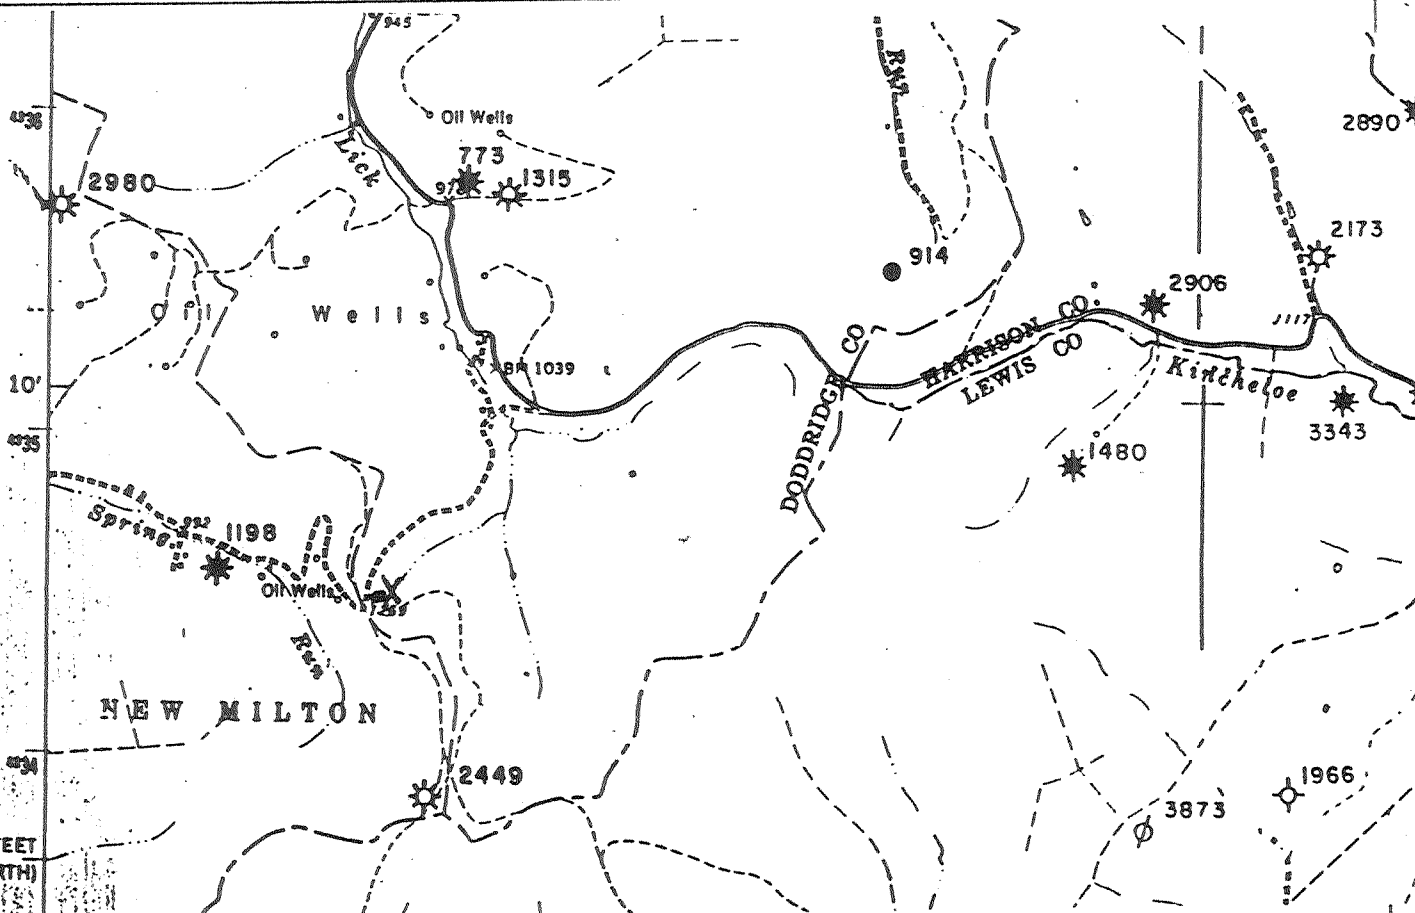

I, the undersigned, hereby certify that this plat is correct to the best of my knowledge and belief.

SIGNED Lowell P BEE

TITLE Pres

DATE May 20, 19 92

OPERATORS WELL NO. DEWISON 3

API WELL NO. 017-3964

STATE OF WEST VIRGINIA
DEPARTMENT OF ENERGY
OIL AND GAS DIVISION

WELL TYPE: OIL GAS LIQUID INJECTION _____ WASTE DISPOSAL _____
(IE "GAS" PRODUCTION STORAGE _____ DEEP _____ SHALLOW _____)

LOCATION: ELEVATION 1269 WATER SHED BEECH LICK RUN
DISTRICT GREENBRIER COUNTY DODDRIDGE
QUADRANGLE BIG ISAAC

SURFACE OWNER CLARENCE SMITH JR ACREAGE _____

OIL & GAS ROYALTY OWNER _____ LEASE ACREAGE 30
LEASE NO. _____

PRODUCING FORMATION BIG INJUN TOTAL DEPTH 2269

WELL OPERATOR BEECHLICK OIL, INC. DESIGNATED AGENT LOWELL P BEE

ADDRESS RT 3 BOX 26 ADDRESS RT 3 BOX 62

SALEM, WV 26426 SALEM, WV 26426

JUL 21 1992