


LATITUDE 39° 10' 00"
~~39° 10' 00"~~
39 10

LATITUDE 80° 33' 00"
80 33 00

INSTRUCTIONS

1) Attach a photo copy of the location of the well on a 7.5 minute Quadrangle with the corresponding Longitude and Latitude.
2) Designate the location of the well with the symbol (+).

67005
87000
0-345
164

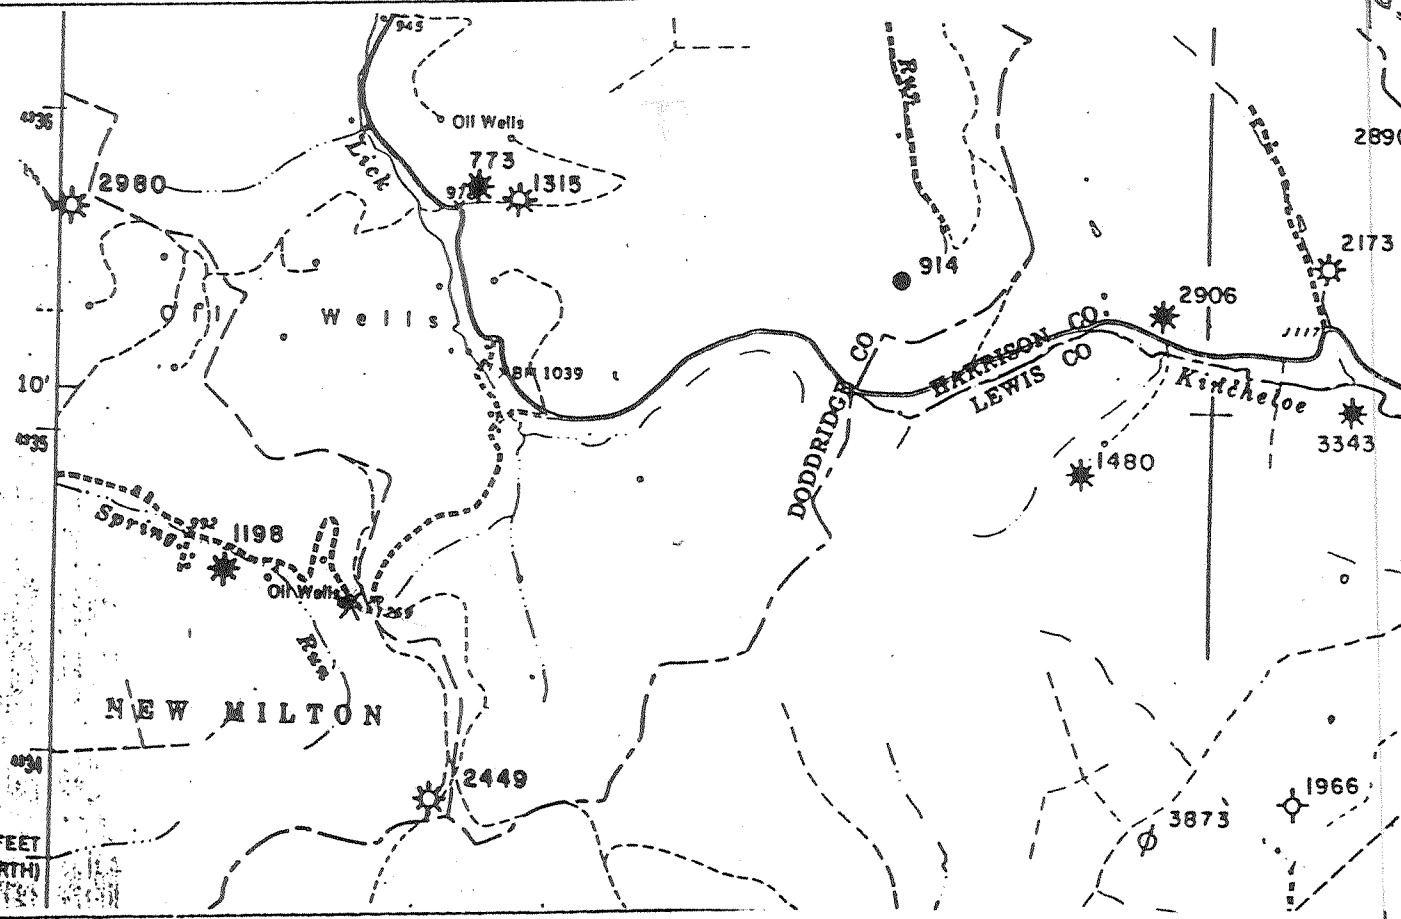

I, the undersigned, hereby certify that this plat is correct to the best of my knowledge and belief.

SIGNED Lowell P Bee

TITLE Pres

DATE May 21, 1992

OPERATORS WELL NO AG Nicholson 1

API WELL NO. 017-3966

STATE OF WEST VIRGINIA
DEPARTMENT OF ENERGY
OIL AND GAS DIVISION

WELL TYPE: OIL GAS LIQUID INJECTION WASTE DISPOSAL
(IF "GAS" PRODUCTION STORAGE DEEP SHALLOW

LOCATION: ELEVATION 1350 WATER SHED SPRING RUN
DISTRICT NEW MILTON COUNTY DODDRIDGE
QUADRANGLE BIG ISAAC

SURFACE OWNER HERBERT BICKFORD ACREAGE _____

OIL & GAS ROYALTY OWNER _____ LEASE ACREAGE 16
LEASE NO. _____

PRODUCING FORMATION BIG INJUN TOTAL DEPTH 2265

WELL OPERATOR BEECHLICK OIL INC. DESIGNATED AGENT Lowell P BEE

ADDRESS RT 3 Box 26 ADDRESS RT 3 Box 62
SALEM WV 26426 SALEM WV 26426

JUL 21 1992