10° 47 '30"

Longitude

Topo Location

7.5' Loc. 2.28s 15' Loc. 2.28s 0.79W (calc.) 3.02W

Company New Od & Gas Co., Inc.

Farm Gene Walton, tal


15' Quad Vadis (NW)

(sec.)

7.5' Quad New Milton

WELL LOCATION PLAT

County <u>017</u> Permit <u>3983</u>

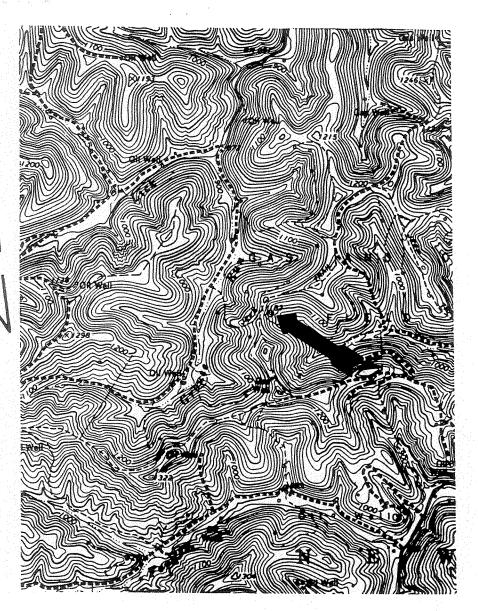

Percento Office of Oil & Gas Permitting

0 3 92

WV Division of invironmental Protection

DRAWING NO	
SCALE	
MINIMUM DEGREE OF	V
ACCURACY	
PROVEN SOURCE OF	
ELEVATION	

I THE UNDERSIGNED, HEREBY CERTIFY THAT THIS PLAT IS CORRECT TO THE BEST OF MY KNOWLEDGE AND BELIEF AND SHOWS ALL THE INFORMATION REQUIRED BY LAW AND THE REGU-LATIONS ISSUED AND PRESCRIBED BY THE DEPART. MENT OF MINES.

(SIGNED).

PLACE SEAL HERE

(+) DENOTES LOCATION OF WELL ON UNITED STATES TOPOGRAPHIC MAPS

FORM IV-6 (8.78)



DATE July 23. OPERATOR'S WELL NO. John Walton #7 API WELL NO.

017 STATE COUNTY

STATE OF WEST VIRGINIA DEPARTMENT OF MINES

OIL AND GAS DIVISION

WELL TYPE: OIL __GAS X LIQUID INJECTION__ WASTE DISPOSAL.

(IF "GAS,") PRODUCTION___STORAGE__DEEP_ _SHALLOW_X_

1125 WATER SHED_ Toms Fork LOCATION: ELEVATION_

New Milton Doddridge DISTRICT_ COUNTY.

New Milton QUADRANGLE.

SURFACE OWNER Gene Walton, et al 204

ACREAGE. OIL & GAS ROYALTY OWNER Gene Walton, et al LEASE ACREAGE.

LEASE NO ..

PROPOSED WORK: DRILL. CONVERT ___DRILL DEEPER_ REDRILL.

STIMULATE __PLUG OFF OLD FORMATION __PERFORATE NEW

FORMATION__OTHER PHYSICAL CHANGE IN WELL (SPECIFY).

PLUG AND ABANDON_ CLEAN OUT AND REPLUG

Big Injun 2100' TARGET FORMATION_ ESTIMATED DEPTH.

WELL OPERATOR WACO OIL & GAS CO. DESIGNATED AGENT STEPHEN E. HOLLOWAY

P.O. BOX 397 P.O. BOX 397 GLENVILLE, WV 26351

GLENVILLE, WV 26351