


PULLMAN QUADRANGLE
WEST VIRGINIA
7.5 MINUTE SERIES (TOPOGRAPHIC)
NW/4 HOLBROOK 15' QUADRANGLE

4352 IV SE
(WEST UNION)

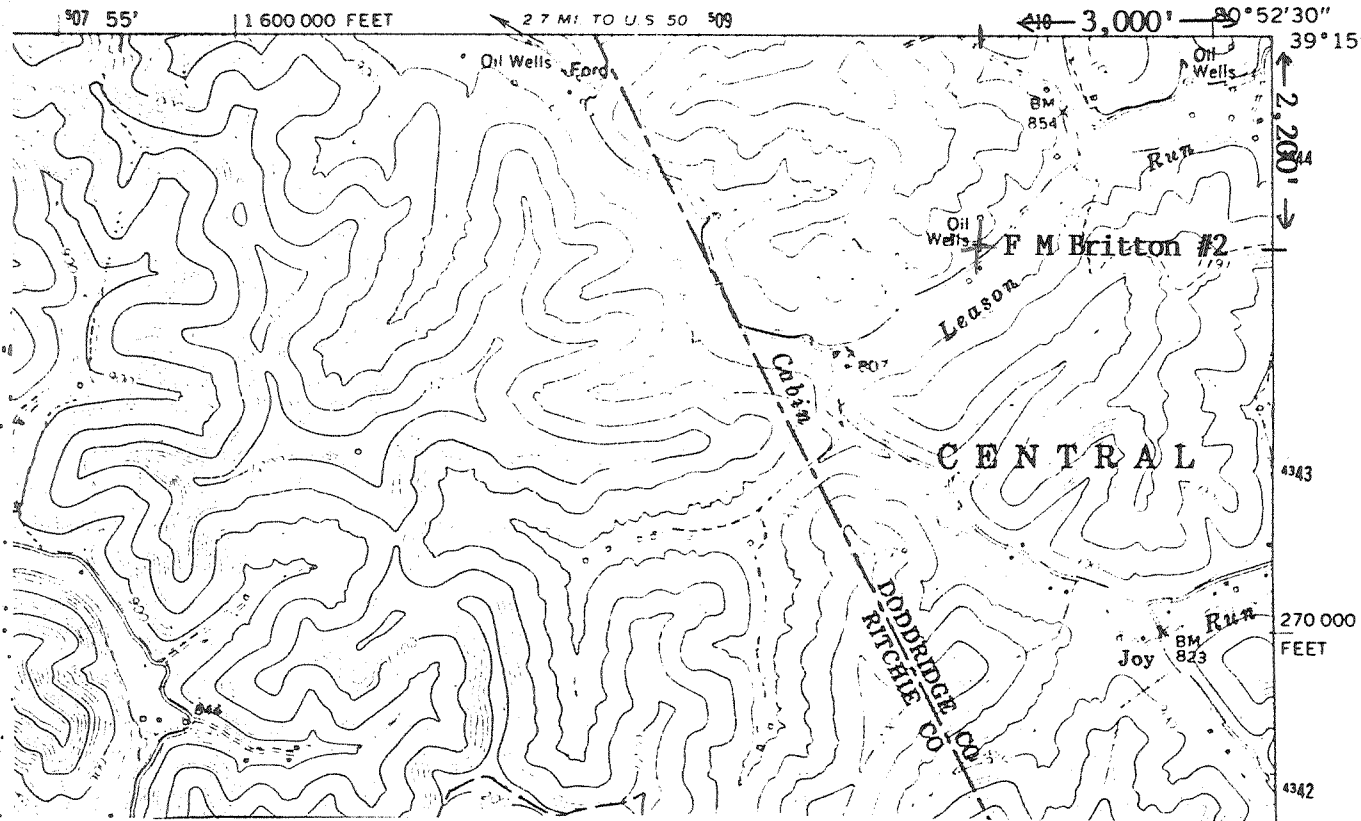

0.415
0.57W

I, the undersigned, hereby certify that this plat is correct to the best of my knowledge and belief.

calc 15' loc
0.415
2.80W

RECEIVED
WV Division of
Environmental Protection

SIGNED Thomas J. Fluharty
TITLE President

JUN 29 83

Permitting
Office of Oil & Gas

DATE June 21, 19 93

OPERATORS WELL NO. #2

API WELL NO. 017-4024-N

STATE OF WEST VIRGINIA
DEPARTMENT OF ENERGY
OIL AND GAS DIVISION

WELL TYPE: OIL GAS LIQUID INJECTION _____ WASTE DISPOSAL _____
TYPE "GAS" PRODUCTION STORAGE _____ DEEP _____ SHALLOW

LOCATION: ELEVATION 880' WATER SHED Leason Run
DISTRICT Central COUNTY Doddridge
QUADRANGLE Pullman SL Holbrook NC

SURFACE OWNER Unknown At This Time = UATT ACREAGE UATT

OIL & GAS ROYALTY OWNER F M Britton LEASE ACREAGE UATT
LEASE NO. UATT

PRODUCING FORMATION Big Injun TOTAL DEPTH UATT

WELL OPERATOR Fluharty Enterprises, Inc. DESIGNATED AGENT Thomas J. Fluharty

ADDRESS P. O. Box 226 ADDRESS P. O. Box 226
Salem, WV 26426 Salem, WV 26426

17534

17480

STATE OF WEST VIRGINIA
DIVISION OF ENVIRONMENTAL PROTECTION
SECTION OF OIL AND GAS

WELL REGISTER ASSIGNMENT

This API Number 47- 17-04024, issued to FLUHARTY ENTERPRISES, INC. is evidence of permission to operate the well that is referenced at the location described on the attached plat, subject to the provisions of Chapters 22 and 22B of the West Virginia Code of 1931, as amended, and all rules and regulations promulgated thereunder. The name and telephone number of the Oil and Gas Inspector for this well is MIKE UNDERWOOD - 304-782-1043.

Spills or emergency discharges must be reported to 1-800-654-3312.

Failure to abide by all statutory and regulatory provisions governing all duties and operations hereunder may result in suspension or revocation of your permits and in addition may result in civil and/or criminal penalties.

The enclosed WR-35 must be completed by you and returned to this office. In addition annual production reports must be submitted on this well and failure to do so may require you to plug the well.

Theodore M. Streit
Chief

By: 

Title: _____

Operator's Well No: F.M. BRITTON #2

Farm Name:

API Well Number : 47- 17-04024 N

Date Issued : 06/30/93